

MISSISSIPPI DEPARTMENT OF NATURAL RESOURCES

Bureau of Land and Water Resources

Southport Mall

P.O. Box 10631

Jackson, Mississippi 39209

CODED

WATER WELL DRILLERS LOG

JACKSON  
Q 294  
3-14-81

3-14-81 19 Coas Water Well Service Jackson  
date well completed firm name county well located

LANDOWNER: Lloyd Elsworth  
3721 Old Spanish Trail  
Gautier, Miss. 39553  
(mailing address)

WELL LOCATION:  
sec. 29 T 7 S R 7 E  
6 miles E of Spring  
(distance) (direction) (nearest town)

WELL PURPOSE: Home  
(home, irrigation, municipal, industrial)

WELL COMPLETION DATA:  
(1) diameter (inches) 2"  
(2) total depth (feet) 718'  
(3) static water level (feet) 35' below top of ground.  
(4) casing PVC, 708'  
(material) (depth)  
2" if telescope see back.  
(size)  
(5) screen 10' 708'  
(length) (depth to top)  
2" PVC  
(size) (material)  
(6) pump 1 hp 9  
(HP) (yield gpm)  
Elect.  
(type power)  
(7) electric log 16.  
(yes or no)  
(organization running log)

(8) how well bottom plugged  
back wash valve

DRILLERS REMARKS:

description of formations encountered	from	to
Top soil	0	10'
B. Clay	10'	30'
B. Clay sand	30'	70'
B. Clay	70'	130'
M. sand	130'	155'
B. Clay	155'	165'
C. sand	165'	175'
B. Clay	175'	315'
F. Sand	315'	340'
B. Clay	340'	643'
M. C. sand	643'	718'


DEPT. OF NATURAL RESOURCES  
BUREAU OF LAND & WATER RESOURCES

APR - 9 1981  
RECEIVED

If well telescopes please sketch and show depths.

0826

GROUND LEVEL

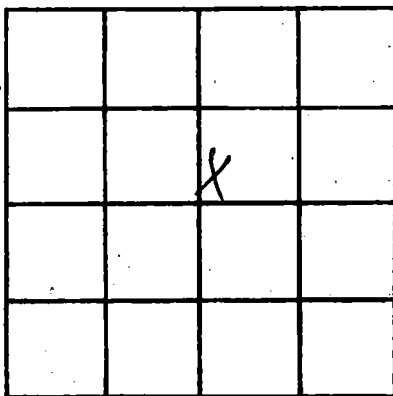

SECTION 29

Please indicate well location X.

**ADDITIONAL INFORMATION**

If more than one screen, show locations of each on sketch.