

MISSISSIPPI DEPARTMENT OF NATURAL RESOURCES

Bureau of Land and Water Resources

Southport Mall

P.O. Box 10631

CODED

Jackson, Mississippi 39209

WATER WELL DRILLERS LOG

JACKSON
Ø 295
3-14-81
GW-3433

3-14 date well completed

firm name

county well located

81 Coas & Water Well Serv. Jackson

LANDOWNER: Feat. Coas & Water Well Serv.
Gautier Utilities
3509 San Juan Circle
Gautier, Miss.
(mailing address)

description of formations encountered

from

to

Top soil	0	5'
Blue Clay and Clay shell	5	48'
Gray Coarse sand	48	100'
Blue Clay and streak of sand	100	200'
Gray Coarse sand	200	325'
Blue Clay	325	496'
Gray Coarse sand	496	584'

WELL LOCATION:

sec. 15 8 S R 7 W
1N miles (distance) of GAUTIER (direction) (nearest town)

WELL PURPOSE:

(home, irrigation, municipal, industrial)

WELL COMPLETION DATA:

- (1) diameter (inches) 8" x 6"
- (2) total depth (feet) 584
- (3) static water level (feet) 59 below above top of ground.
- (4) casing Steel (material) 554' (depth)
- 8" x 6" (size) If telescope see back.
- (5) screen 30' Steel (length) 554' (depth to top)
- 8" x 6" (size) Steel (material)
- (6) pump (HP) (yield gpm)
- Electric (type power)
- (7) electric log No. (yes or no)
- (organization running log)



(8) How well bottom plugged Back Wash Valve

DRILLERS REMARKS:

DEPT. OF NATURAL RESOURCES
BUREAU OF LAND & WATER RESOURCES

APR - 9 1981
RECEIVED

If well telescopes please sketch and show depths.

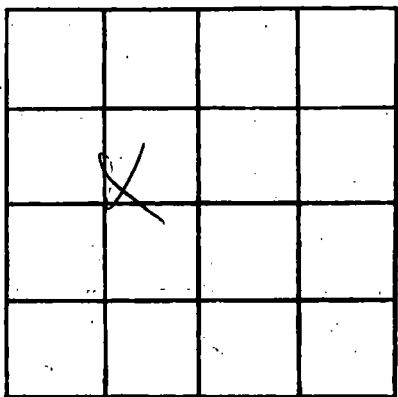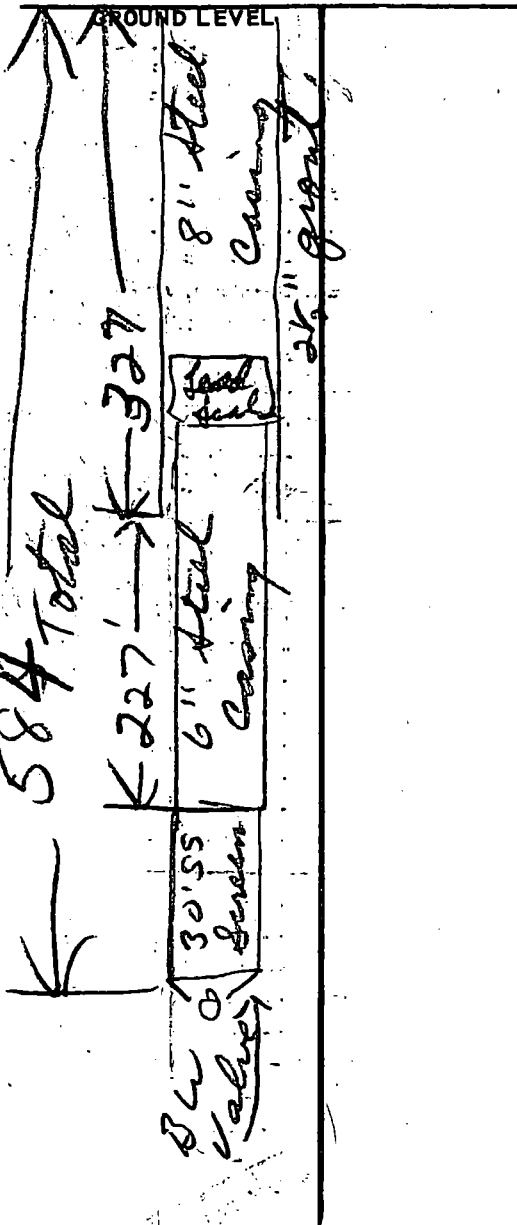

SECTION 15FG

Please indicate well location X.

ADDITIONAL INFORMATION

If more than one screen, show locations of each on sketch.