

MISSISSIPPI DEPARTMENT OF NATURAL RESOURCES

Bureau of Land and Water Resources

Southport Mall

P.O. Box 10631

Jackson, Mississippi 39201

WATER WELL DRILLERS LOG

CODED

0299  
 JACKSON  
 8-19-83

8/19/83 19 Lyman Well Co. Jackson  
 date well completed firm name county well located

LANDOWNER: Thomas Lawrence  
P.O. Box 931  
Ocean Springs 39564  
 (mailing address)

WELL LOCATION:  
 sec. 19 T. 7 N R. 7 E  
9 miles N of Gardier  
 (distance) (direction) (nearest town)

WELL PURPOSE: Home  
 (home, irrigation, municipal, industrial)

WELL COMPLETION DATA:

(1) diameter (inches) 4"

(2) total depth (feet) 390'

(3) static water level (feet) 60' <sup>below</sup> above top of ground.

(4) casing PVC 370'  
 (material) (depth)  
4"  
 (size) if telescope see back.

(5) screen 20' 370'  
 (length) (depth to top)  
4" PVC  
 (size) (material)

(6) pump 1 1/2 34  
 (HP) (yield gpm)  
electric  
 (type power)

(7) electric log No  
 (yes or no)  
No  
 (organization running log)

(8) how well bottom plugged sand  
shark

description of formations encountered	from	to
<u>Blue Grey Lumber</u>	<u>0</u>	<u>160</u>
<u>Fine Sand</u>	<u>160</u>	<u>240</u>
<u>Blue Clay &amp; Rock</u>	<u>240</u>	<u>260</u>
<u>Blue Clay</u>	<u>260</u>	<u>300</u>
<u>Shells</u>	<u>300</u>	<u>310</u>
<u>Fine Sand &amp; Clay</u>	<u>310</u>	<u>360</u>
<u>Wood Sand</u>	<u>360</u>	<u>390</u>


DRILLERS REMARKS:

DEPT. OF NATURAL RESOURCES  
 BUREAU OF LAND & WATER RESOURCES

APR 20 1984  
 RECEIVED

If well telescopes please sketch and show depths.

GROUND LEVEL

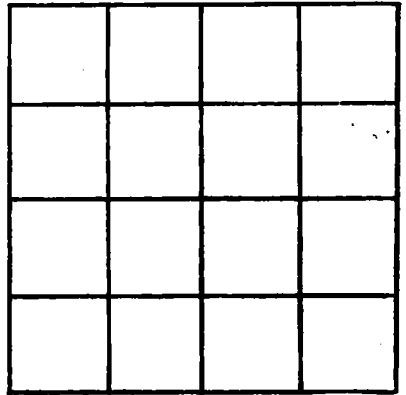

SECTION \_\_\_\_\_

Please indicate well location X.

ADDITIONAL INFORMATION

If more than one screen, show locations of each on sketch.