

MISSISSIPPI DEPARTMENT OF NATURAL RESOURCES
 Bureau of Land and Water Resources
 Southport Mall
 P.O. Box 10631
 Jackson, Mississippi 39209
WATER WELL DRILLERS LOG

CODED

JACKSON
 Q 302

8-21-1984 date well completed
 84 Coash Water Well Sew. Jackson firm name
 county well located

LANDOWNER: Mills, Inc.
44 S. Penny Ave Hwy 90E
Pascagoula, Miss.
 (mailing address) 39567

description of formations encountered	from	to
<u>Sandy Top Soil</u>	<u>0</u>	<u>15'</u>
<u>Blue Clay</u>	<u>15'</u>	<u>60'</u>
<u>Coarse sand</u>	<u>60'</u>	<u>90'</u>

WELL LOCATION:
 sec. 35 T. 7 N. R. 7 E
S W
1N miles — of Gautier
 (distance) (direction) (nearest town)

WELL PURPOSE:
 (home, irrigation, municipal, industrial)

WELL COMPLETION DATA:

- (1) diameter (inches) 4"
- (2) total depth (feet) 90'
- (3) static water level (feet) 30' below above top of ground.
- (4) casing PVC, 80'
 (material) (depth)
4"
 (size) if telescope see back.
- (5) screen 10', 80'
 (length) (depth to top)
4" PVC
 (size) (material)
- (6) pump 1 1/2 hp., 27
 (HP) (yield gpm)
Elect.
 (type power)
- (7) electric log No
 (yes or no)
- (8) how well bottom plugged
Black Wash Valve

DRILLERS REMARKS:


CODED

DEPT. OF NATURAL RESOURCES
 BUREAU OF LAND & WATER RESOURCES

OCT 12 1984
 RECEIVED

If well telescopes please sketch and show depths.

GROUND LEVEL

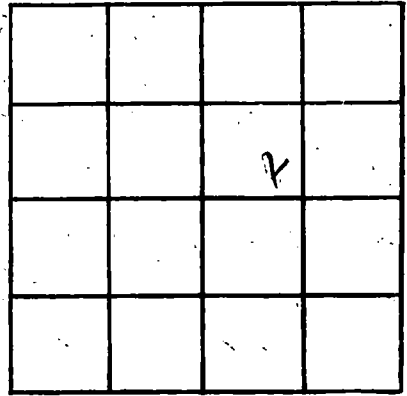

SECTION 35

Please indicate well location X.

ADDITIONAL INFORMATION

If more than one screen,
show locations of each on sketch.