

# MISSISSIPPI DEPARTMENT OF NATURAL RESOURCES

Bureau of Land and Water Resources

Southport Mall

P.O. Box 10631

CODED

Jackson, Mississippi 39209

## WATER WELL DRILLERS LOG

JACKSON

303

8-31-84

Coast Water Well Sew. Jackson

Date well completed

firm name

county well located

Land Planning Consultants  
P.O. Box 26,  
Gautier, Miss.

description of formations encountered

from

to

Top soil	0	5'
Red Clay & Wood	5'	17'
Blue Clay	17'	47'
Blue Clay & Wood	47'	84'
White Coarse sand & wood	84'	110'
Blue Clay & Shale	110'	134'
Blue Clay	134'	160'
Blue Clay & Shale	160'	183'
Blue Clay	183'	200'
Blue fine sand	200'	235'
Blue Clay	235'	410'
Shag Coarse sand	410'	473'

### WELL LOCATION:

sec. 18 T 7 N R 7 E  
S W  
2 miles East of Ocean Springs  
(distance) (direction) (nearest town)

### WELL PURPOSE:

(home, irrigation, municipal, industrial)

### WELL COMPLETION DATA:

- (1) diameter (inches) 6 x 4
- (2) total depth (feet) 473
- (3) static water level (feet) 50 below above  
top of ground.
- (4) casing PVC 443'  
(material) (depth)  
6 x 4"  
(size) If telescope see back.
- (5) screen 30' 443'  
(length) (depth to top)  
6 x 4" POC  
(size) (material)
- (6) pump 5 hp 80  
(HP) (yield gpm)  
Electric  
(type power)
- (7) electric log No  
(yes or no)

(organization running log)



(8) how well bottom plugged

DRILLERS REMARKS:

CODED

RECEIVED  
OCT 13 1984

If well telescopes please  
sketch and show depths.

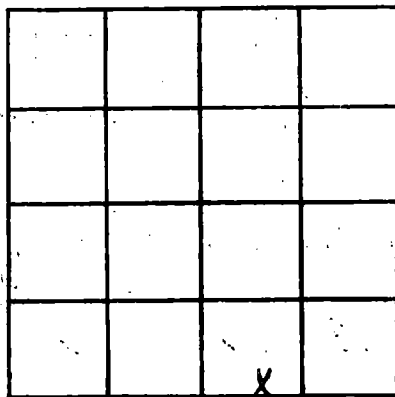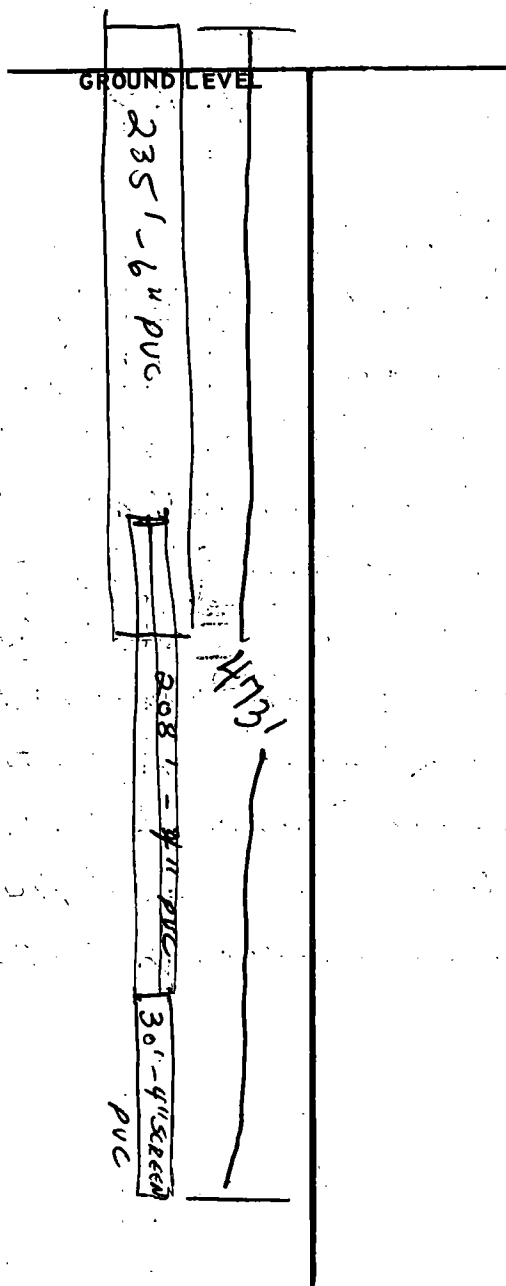

SECTION 18

Please indicate well location X.

ADDITIONAL INFORMATION

If more than one screen,  
show locations of each on sketch.