

MISSISSIPPI DEPARTMENT OF NATURAL RESOURCES

Bureau of Land and Water Resources

Southport Mall

P.O. Box 10631

CODED

Jackson, Mississippi 39209

WATER WELL DRILLERS LOG

COASTAL DRILLING & SERVICE CO.

JACKSON  
# 304

*Jackson*  
county well located

11/15/83  
date well completed

ROUTE 1 BOX 619  
firm name

BILOXI, MISS. 39532

LANDOWNER: *Robt. Moore*  
*Brethert Church*  
*Hwy 57 Ocean Springs*  
(mailing address)

description of formations encountered	from	to
<i>top soil</i>	<i>1</i>	<i>3</i>
<i>Red Clay</i>	<i>3</i>	<i>15</i>
<i>gray sand</i>	<i>15</i>	<i>40</i>
<i>base white sand</i>	<i>40</i>	<i>96</i>

WELL LOCATION:  
sec. *5* T. *2* N. R. *2* E  
*2* S. *10* W  
*2 1/2* miles North of *10*  
(distance) (direction) (nearest town)

WELL PURPOSE: *Church*  
(home, irrigation, municipal, industrial)

- WELL COMPLETION DATA:
- (1) diameter (inches) *2"*
  - (2) total depth (feet) *96'*
  - (3) static water level (feet) *10'* below above top of ground.
  - (4) casing *PVC* *86'*  
(material) (depth)  
(size) if telescope see back.
  - (5) screen *10'* *86'*  
(length) (depth to top)  
*2"* *PVC*  
(size) (material)
  - (6) pump *None* *12*  
(HP) (yield gpm)  
*Ele*  
(type power)
  - (7) electric log *yes*  
(yes or no)
- (organization running log)

(8) how well bottom plugged  
*2' bedrock below*  
DRILLERS REMARKS: *19-12*

*Push*

CODED


DEPT. OF NATURAL RESOURCES  
BUREAU OF LAND & WATER RESOURCES

NOV 8 1984

RECEIVED

If well telescopes please sketch and show depths.

GROUND LEVEL

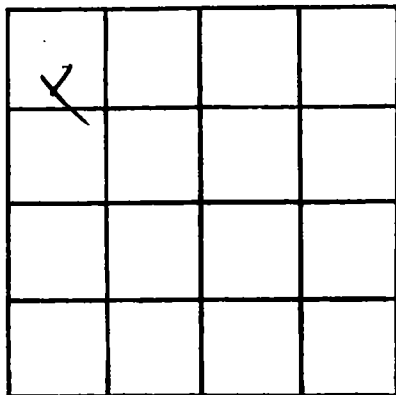

SECTION \_\_\_\_\_

Please indicate well location X.

ADDITIONAL INFORMATION

If more than one screen, show locations of each on sketch.