

MISSISSIPPI DEPARTMENT OF NATURAL RESOURCES

Bureau of Land and Water Resources

Southport Mall

P.O. Box 10631

Jackson, Mississippi 39209

WATER WELL DRILLERS LOG

CODED

JACKSON
 305

5-28-85
 date well completed

Coast Water Well Saw.
 firm name

Jackson
 county well located

LANDOWNER: Longest Parry
 15205 Invermont Dr.
 Biloxi, Miss. 39532
 (mailing address)

WELL LOCATION:
 sec 29 T 7 N R 7 E
3 miles EAST of OCEAN SPRINGS
 (distance) (direction) (nearest town)

WELL PURPOSE: Home
 (home, irrigation, municipal, industrial)

WELL COMPLETION DATA:

- (1) diameter (inches) 2"
- (2) total depth (feet) 750'
- (3) static water level (feet) 45' below top of ground
- (4) casing PVC 730'
 (material) (depth)
- 2" if telescope see back.
 (size)
- (5) screen 20' 730'
 (length) (depth to top)
- 2" PVC
 (size) (material)
- (6) pump 1/2 HP 10
 (HP) (yield gpm)
- Electric
 (type power)
- (7) electric log No
 (yes or no)
- (organization running log)

description of formations encountered	from	to
Top soil	0	1'
Slump	1'	3'
Coarse white sand	3'	85'
Blue Clay	85'	107'
Coarse white sand	107'	190'
Blue Clay - slip sand	190'	255'
Blue Clay	255'	320'
Coarse pebbly sand	320'	345'
Blue Clay / shell	345'	475'
Blue Clay / slump sand	475'	535'
Blue Clay	535'	620'
Blue Clay / slip sand	620'	705'
Coarse pebbly sand	705'	750'

5' 2" Tail pipe
 CODED

RECEIVED
 JUL 10 1985


(8) how well bottom plugged
Back with valve

DRILLERS REMARKS:

Department of Natural Resources
 BUREAU OF LAND & WATER RESOURCES

If well telescopes please sketch and show depths.

GROUND LEVEL

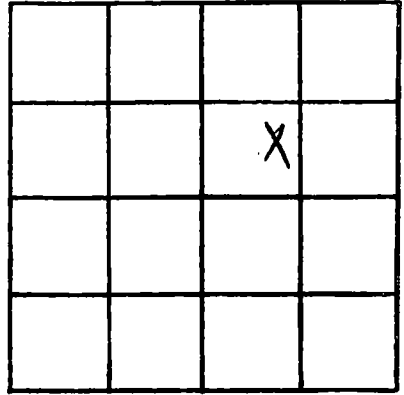

SECTION 29

Please indicate well location X.

ADDITIONAL INFORMATION

If more than one screen,
show locations of each on sketch.