

**MISSISSIPPI DEPARTMENT OF ENVIRONMENTAL QUALITY**  
Office of Land and Water Resources

P. O. Box 10631  
Jackson, MS 39289-0631  
**WATER WELL DRILLERS LOG**

0-426  
COUNTY WELL LOCATED  
**JACKSON**  
WELL NUMBER CODED  
0-426  
DATE WELL COMPLETED  
10-12-02

PERMIT NUMBER  
**Coast Water Well Service**

NAME & MAILING ADDRESS OF LANDOWNER  
**Richard Dickson**  
**Belle Fountain**  
Latitude:  
Longitude: **Ocean Springs, Ms**  
WELL LOCATION SEC TOWNSHIP RANGE  
**18 8 7**  
DISTANCE DIRECTION NEAREST TOWN  
**6 Miles SE of Ocean Springs**  
OTHER LANDMARK  
WELL PURPOSE  Home Irrigation, Municipal, Industrial, Fish Pond, etc.

**PUMP DATA**

PUMP TYPE (Circle One):  
 Submersible,  Turbine,  Jet,  Flowing Well,  
Other (Describe) \_\_\_\_\_  
POWER TYPE (Circle One):  
 Electric,  Tractor,  Diesel,  Gasoline,  Butane,  
Other (Describe) \_\_\_\_\_ H/P \_\_\_\_\_

DESCRIPTION OF FORMATIONS ENCOUNTERED	FROM	TO
White coarse sand	0	37
Gray clay	37	58
White coarse sand	58	79
Blue clay w/str of sand	79	175
Gray medium sand	175	218
Blue clay	218	390
Gray coarse sand	390	420

**WELL DATA**

Well Depth: **420'** Casing Diameter (In.): **4" x 2"** Casing Length (Ft.): **400'**  
Type of Casing: **PVC** Hole Depth: **420'** Depth to Static Water Level: **50'**  
TYPE OF COMPLETION: (Circle One or More):  
 Gravel Packed,  Underreamed,  Telescoped,  
 Natural Development,  Open Hole,  Other  
(Describe) \_\_\_\_\_  
WELL GROUTED TO A DEPTH OF **60** FEET  
Type Grout (circle one): Cement,  Bentonite, or Mix

**SCREEN DATA**

Diameter - Inches: **2"** Length - Feet: **20'** Slot Size - Inches: **.008**  
Screen Type: **PVC** Depth to Bottom - Feet: **420'**

**RECEIVED**  
**NOV 08 2002**  
**BY: OLWR**  
Top of Last Pipe or Reduction in Casing  
FEET  IF TELESCOPED OR MORE THAN ONE SCREEN: USE BACK PAGE


I certify that the well was drilled, constructed and completed in accordance with all applicable Requirements of the Mississippi Department of Environmental Quality and/or the Mississippi Department of Health regulations and state laws.

**Jack Redell 472**  
Signature of Licensed Driller and License No.

**11-5-02**  
Date

Additional Information Required On Back

If well telescopes please sketch and show depths.

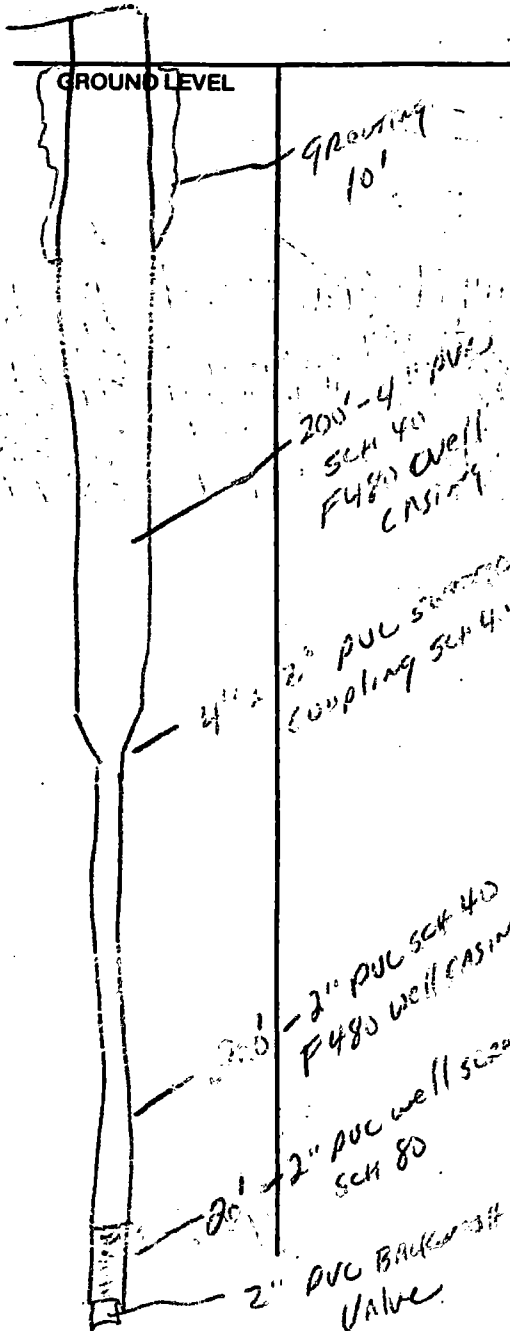

If more than one screen, show location of each on sketch.

*Handwritten notes:* 10/11/00

		X	

SECTION 10

Please indicate well location X.

Pump Capacity (GPM)	No. of Stages	Setting Depth	
19	7	100	FT.

PUMP TEST

Well yielded \_\_\_\_\_ GPM with a drawdown of \_\_\_\_\_ ft. after \_\_\_\_\_ hours of pumping

LOG DATA

TYPE OF LOG RUN (Circle One): No Log Run  
 Electric, Gamma Ray, Density, Sonic, Neutron, Other (Describe)

Name of Organization Running Log

GEOLOGIC DATA (Office Use Only)

Surface Elev.	Geologic Unit	Unit Thickness	Depth to Top
Subs. SWL	Date	Analysis	Aquifer Test

Driller's Remarks

---



---



---



---