

MISSISSIPPI DEPARTMENT OF ENVIRONMENTAL QUALITY

Office of Land and Water Resources

P. O. Box 10631
Jackson, MS 39289-0631
WATER WELL DRILLERS LOG

COUNTY WELL LOCATED
JACKSON

WELL NUMBER CODED
Φ - 434

DATE WELL COMPLETED
Sept 23, 02

PERMIT NUMBER
MTM well

NAME OF DRILLING FIRM
8827 BOSS HUSLEY

BLOXI

NAME & MAILING ADDRESS OF LANDOWNER
**Broderick
Hautier / Vorelve Rd**

Latitude:
Longitude:

WELL LOCATION. SEC TOWNSHIP RANGE
4 7 N 7 E

DISTANCE DIRECTION NEAREST TOWN
3 Miles N of Vorelve

OTHER LANDMARK
NONE

WELL PURPOSE: Home Irrigation, Municipal, Industrial, Fish Pond, etc.
Home

PUMP DATA

PUMP TYPE (Circle One):
Submersible, Turbine, **Flowing Well**,
Other (Describe) _____

POWER TYPE (Circle One):
 Electric, Tractor, Diesel, Gasoline, Butane,
Other (Describe) _____ H/P **1**

DESCRIPTION OF FORMATIONS ENCOUNTERED	FROM	TO
Top soil	1	5
sand	5	25
gray clay	25	95
green clay	95	230
sand	230	270

WELL DATA

Well Depth 270	Casing Diameter (In.) 2"	Casing Length (Ft.) 260
Type of Casing PVC	Hole Depth 270	Depth to Static Water Level 50'

TYPE OF COMPLETION: (Circle One or More):
 Natural Development, Gravel Packed, Underreamed, Telescoped,
 Open Hole, Other

WELL GROUTED TO A DEPTH OF **11** FEET
Type Grout (circle one): Cement, Bentonite, or Mix

SCREEN DATA

Diameter - Inches 2"	Length - Feet 10	Slot Size - Inches .006
Screen Type PVC	Depth to Bottom - Feet 260-270	

RECEIVED

FEB 10 2003

BY: OLWR

Top of Lap Pipe or Reduction in Casing

FEET IF TELESCOPED OR MORE THAN ONE SCREEN: USE BACK PAGE

I certify that the well was drilled, constructed and completed in accordance with all applicable Requirements of the Mississippi Department of Environmental Quality and/or the Mississippi Department of Health regulations and state laws.


Alb Molder 0563
Signature of Licensed Driller and License No.

Feb 6, 03
Date

Additional Information Required On Back

If well telescopes please sketch and show depths.

GROUND LEVEL

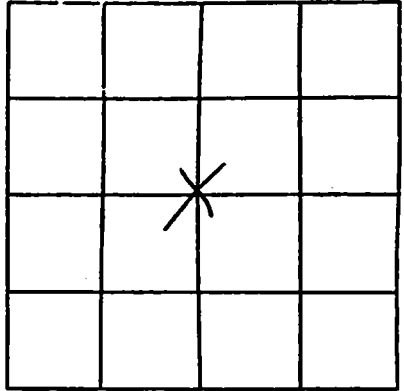

SECTION 4

Please indicate well location X.

Pump Capacity (GPM)	No. of Stages	Setting Depth
<u>12</u>	<u>2</u>	<u>20'</u> FT.

PUMP TEST

Well yielded 14 GPM with
a drawdown of 55' ft.
after _____ hours of pumping

LOG DATA

TYPE OF LOG RUN (Circle One): No Log Run.
 Electric, Gamma Ray, Density, Sonic, Neutron.
Other (Describe) _____

Name of Organization Running Log _____

GEOLOGIC DATA (Office Use Only)

Surface Elev.	Geologic Unit	Unit Thickness	Depth to Top
Subs. SWL	Date	Analysis	Aquifer Test

Driller's Remarks

If more than one screen,
show location of each on sketch.