

MISSISSIPPI DEPARTMENT OF ENVIRONMENTAL QUALITY

Office of Land and Water Resources

P. O. Box 10631

Jackson, MS 39289-0631

WATER WELL DRILLERS LOG

COUNTY WELL LOCATED Jackson	
WELL NUMBER Q-445	CODED
DATE WELL COMPLETED 9/21/10	

PERMIT NUMBER MS-1111
NAME OF DRILLING FIRM 8827 BOSS Hqs Coy
Biloxi

NAME & MAILING ADDRESS OF LANDOWNER
FEB Design

1105 oak

Latitude:
Longitude:

WELL LOCATION: SEC **6** TOWNSHIP **8 N** RANGE **7 E**

DISTANCE **1/4** Miles **East** of **Flair**

OTHER LANDMARK
St. Charles Stone

WELL PURPOSE: Home, Irrigation, Municipal, Industrial, Fish Pond, etc.
Home

PUMP DATA

PUMP TYPE (Circle One):
Submersible, Turbine, **Jet** Flowing Well,
Other (Describe)

POWER TYPE (Circle One):
 Electric Tractor, Diesel Gasoline, Butane,
Other (Describe) **1 HP** H/P

DESCRIPTION OF FORMATIONS ENCOUNTERED	FROM	TO
Brown sil	0	20
green clay	20	35
white sand	35	70
green clay	70	90
sand	90	115

WELL DATA

Well Depth 115	Casing Diameter (in.) 2"	Casing Length (Ft.) 105
--------------------------	------------------------------------	-----------------------------------

Type of Casing PVC	Hole Depth 115	Depth to Static Water Level 10
------------------------------	--------------------------	--

TYPE OF COMPLETION: (Circle One or More):
Gravel Packed, Underreamed, Telescoped,
 Natural Development, Open Hole, Other
(Describe)

WELL GROUTED TO A DEPTH OF **10** FEET
Type Grout (circle one): Cement, Bentonite, or Mix

SCREEN DATA

Diameter - Inches 2"	Length - Feet 10	Slot Size - Inches 1006
--------------------------------	----------------------------	-----------------------------------

Screen Type PVC Adv 40	Depth to Bottom - Feet 105-115
----------------------------------	--

RECEIVED

JUN 23 2003

BY: OLWR

Top of Lap Pipe or Reduction in Casing

FEET IF TELESCOPED OR MORE THAN ONE SCREEN: USE BACK PAGE

I certify that the well was drilled, constructed and completed in accordance with all applicable Requirements of the Mississippi Department of Environmental Quality and/or the Mississippi Department of Health regulations and state laws.


Al Mohr 0563
Signature of Licensed Driller and License No.

6/22/03
Date

Additional Information Required On Back

If well telescopes please sketch and show depths.

GROUND LEVEL

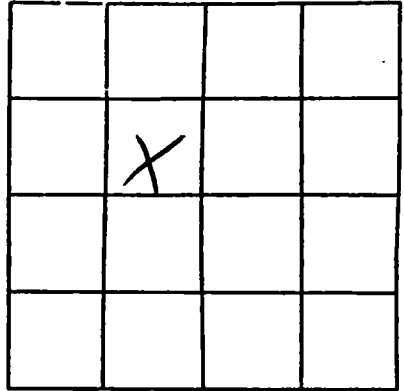

SECTION 6

Please indicate well location X.

Pump Capacity (GPM)	No. of Stages	Setting Depth
<u>15</u>	<u>2</u>	<u>30</u> FT.

PUMP TEST

Well yielded 15 GPM with
a drawdown of 20 ft.
after _____ hours of pumping

LOG DATA

TYPE OF LOG RUN (Circle One): No Log Run, Electric, Gamma Ray, Density, Sonic, Neutron, Other (Describe) _____

Name of Organization Running Log

GEOLOGIC DATA (Office Use Only)

Surface Elev.	Geologic Unit	Unit Thickness	Depth to Top
Subs. SWL	Date	Analysis	Aquifer Test

Driller's Remarks

If more than one screen, show location of each on sketch.