

MISSISSIPPI DEPARTMENT OF ENVIRONMENTAL QUALITY

Office of Land and Water Resources

P. O. Box 10631

Jackson, MS 39289-0631

WATER WELL DRILLERS LOG

COUNTY WELL LOCATED
JACKSON

WELL NUMBER
Q-449

CODED

DATE WELL COMPLETED
MARCH 28

PERMIT NUMBER
MTMall

NAME OF DRILLING FIRM
8827 Boss Hussy

Bilip m

NAME & MAILING ADDRESS OF LANDOWNER
F.E.B. Designs

1124 Dorothy

Latitude:
Longitude:

WELL LOCATION SEC TOWNSHIP RANGE
6 8 N 7 E

DISTANCE DIRECTION NEAREST TOWN
1/4 Miles **east** of **Hailey**

OTHER LANDMARK
Atlanders Store

WELL PURPOSE: Home, Irrigation, Municipal, Industrial, Fish Pond, etc.
Home

PUMP DATA

PUMP TYPE (Circle One):
Submersible, Turbine, Other (Describe) **Flowing Well**

POWER TYPE (Circle One):
 Electric, Tractor, Diesel, Gasoline, Butane, Other (Describe) **1 HP** H/P

DESCRIPTION OF FORMATIONS ENCOUNTERED	FROM	TO
Brown soil	0-20	
gray clay	20-35	
white soil	35-70	
green clay	70-90	
soil	90-115	

WELL DATA

Well Depth 115	Casing Diameter (In.) 2"	Casing Length (Ft.) 105
Type of Casing PVC	Hole Depth 115	Depth to Static Water Level 10'

TYPE OF COMPLETION: (Circle One or More):
Gravel Packed, Underreamed, Telescoped, Natural Development, Open Hole, Other (Describe)

WELL GROUTED TO A DEPTH OF **10 FEET**
Type Grout (circle one): Cement, Bentonite, or Mix

SCREEN DATA

Diameter - Inches 2"	Length - Feet 10'	Slot Size - Inches .006
Screen Type PVC	Depth to Bottom - Feet Ad 40	105-115

RECEIVED

JUN 23 2003

BY: OLWR

Top of Lap Pipe or Reduction in Casing

FEET IF TELESCOPED OR MORE THAN ONE SCREEN: USE BACK PAGE


I certify that the well was drilled, constructed and completed in accordance with all applicable Requirements of the Mississippi Department of Environmental Quality and/or the Mississippi Department of Health regulations and state laws.

Ab Mall 0563
Signature of Licensed Driller and License No.

June 20, 03
Date

If well telescopes please sketch and show depths.

GROUND LEVEL

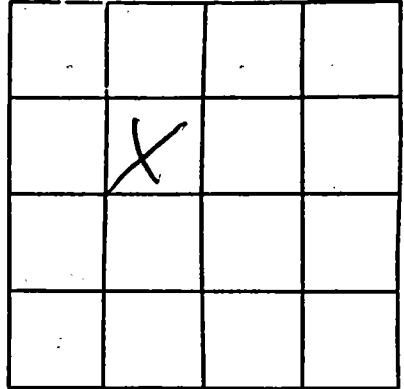

SECTION 6

Please indicate well location X.

Pump Capacity (GPM)	No. of Stages	Setting Depth
<u>15</u>	<u>2</u>	<u>30</u> FT.

PUMP TEST

Well yielded 15 GPM with
a drawdown of 20 ft.
after _____ hours of pumping

LOG DATA

TYPE OF LOG RUN (Circle One): No Log Run, Electric, Gamma Ray, Density, Sonic, Neutron, Other (Describe) _____

Name of Organization Running Log

GEOLOGIC DATA (Office Use Only)

Surface Elev.	Geologic Unit	Unit Thickness	Depth to Top
Subs. SWL	Date	Analysis	Aquifer Test

Driller's Remarks

If more than one screen, show location of each on sketch.