

MISSISSIPPI DEPARTMENT OF ENVIRONMENTAL QUALITY

Office of Land and Water Resources

P. O. Box 10631
Jackson, MS 39289-0631
WATER WELL DRILLERS LOG

COUNTY WELL LOCATED
Jackson

WELL NUMBER CODED
Q-461

DATE WELL COMPLETED
MARCH 28

PERMIT NUMBER
WFM well

NAME OF DRILLING FIRM
8827 Boss Nuey Biloxi

NAME & MAILING ADDRESS OF LANDOWNER
**FEB Designs
1204 Percy**

Latitude:
Longitude:

WELL LOCATION. SEC TOWNSHIP RANGE
6 8 N 7 E

DISTANCE DIRECTION NEAREST TOWN
1/4 Miles east of Slick

OTHER LANDMARK
St Andrews Street

WELL PURPOSE: Home, Irrigation, Municipal, Industrial, Fish Pond, etc.
Home

PUMP DATA

PUMP TYPE (Circle One):
Submersible, Turbine, Flowing Well, Other (Describe) _____

POWER TYPE (Circle One):
 Electric, Tractor, Diesel, Gasoline, Butane, Other (Describe) **HP** H/P _____

DESCRIPTION OF FORMATIONS ENCOUNTERED	FROM	TO
Bam soil	0-20	
gray clay	20-35	
white sand	35-70	
green clay	70-90	
seal	90-115	

WELL DATA

Well Depth Casing Diameter (In.) Casing Length (Ft.)
115 2" 105

Type of Casing Hole Depth Depth to Static Water Level
PVC 115 10

TYPE OF COMPLETION: (Circle One or More):
 Gravel Packed, Underreamed, Telescoped, Natural Development, Open Hole, Other (Describe) _____

WELL GROUTED TO A DEPTH OF **10** FEET
Type Grout (circle one): Cement, Bentonite, or Mix

SCREEN DATA

Diameter - Inches Length - Feet Slot Size - Inches
2" 10 .006

Screen Type Depth to Bottom - Feet
PVC AL140 105-115

Top of Lap Pipe or Reduction in Casing

FEET IF TELESCOPED OR MORE THAN ONE SCREEN: USE BACK PAGE

RECEIVED
JUN 23 2003
BY: OLWR


I certify that the well was drilled, constructed and completed in accordance with all applicable Requirements of the Mississippi Department of Environmental Quality and/or the Mississippi Department of Health regulations and state laws.

[Signature] 0563
Signature of Licensed Driller and License No.

[Signature]
Date

If well telescopes please sketch and show depths.

GROUND LEVEL

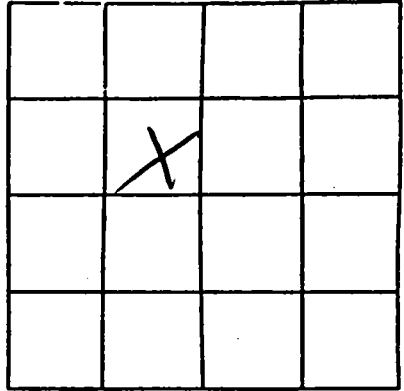

SECTION 6

Please indicate well location X.

Pump Capacity (GPM)	No. of Stages	Setting Depth
<u>15</u>	<u>2</u>	<u>30</u> FT.
PUMP TEST		
Well yielded <u>15</u> GPM with a drawdown of <u>20</u> ft. after _____ hours of pumping		

LOG DATA

TYPE OF LOG RUN (Circle One): No Log Run, Electric, Gamma Ray, Density, Sonic, Neutron, Other (Describe) _____

Name of Organization Running Log _____

GEOLOGIC DATA (Office Use Only)

Surface Elev.	Geologic Unit	Unit Thickness	Depth to Top
Subs. SWL	Date	Analysis	Aquifer Test

Driller's Remarks

If more than one screen, show location of each on sketch.