

MISSISSIPPI DEPARTMENT OF ENVIRONMENTAL QUALITY

Office of Land and Water Resources

P. O. Box 10631
Jackson, MS 39289-0631
WATER WELL DRILLERS LOG

COUNTY WELL LOCATED <i>Jackson</i>	
WELL NUMBER <i>0-455</i>	CODED
DATE WELL COMPLETED <i>July 8</i>	

PERMIT NUMBER <i>m+m well</i>
NAME OF DRILLING FIRM <i>8827 Boss Hardy</i>
<i>Bilert</i>

NAME & MAILING ADDRESS OF LANDOWNER <i>FEB Designs</i>			
<i>117 Elizabeth Octor Springs</i>			
Latitude:			
Longitude:			
WELL LOCATION	SEC	TOWNSHIP	RANGE
	<i>8</i>	<i>8</i>	<i>7</i>
DISTANCE	DIRECTION	NEAREST TOWN	
<i>1/2</i> Miles	<i>west</i>	<i>of Stordaus</i>	
OTHER LANDMARK <i>Stordaus Golf course</i>			
WELL PURPOSE: Home, Irrigation, Municipal, Industrial, Fish Pond, etc. <i>Home</i>			

PUMP DATA	
PUMP TYPE (Circle One): Submersible, Turbine, <input checked="" type="radio"/> Flowing Well , Other (Describe)	
POWER TYPE (Circle One): <input checked="" type="radio"/> Electric , Tractor, Diesel, Gasoline, Butane, Other (Describe) <i>H/P</i>	

DESCRIPTION OF FORMATIONS ENCOUNTERED	FROM	TO
<i>sand</i>	<i>0-20</i>	
<i>gray clay</i>	<i>20-40</i>	
<i>clay + sand mix</i>	<i>40-55</i>	
<i>sand</i>	<i>55-115</i>	

WELL DATA		
Well Depth <i>115</i>	Casing Diameter (In.) <i>2"</i>	Casing Length (Ft.) <i>105</i>
Type of Casing <i>PVC</i>	Hole Depth <i>105</i>	Depth to Static Water Level <i>7</i>
TYPE OF COMPLETION: (Circle One or More): Gravel Packed, Underreamed, Telescoped, <input checked="" type="checkbox"/> Natural Development , Open Hole, Other (Describe)		

WELL GROUTED TO A DEPTH OF <i>10</i> FEET Type Grout (circle one): Cement, Bentonite, or Mix

SCREEN DATA		
Diameter - Inches <i>2"</i>	Length - Feet <i>10</i>	Slot Size - Inches <i>.006</i>
Screen Type <i>PVC</i>	Depth to Bottom - Feet <i>105-115</i>	

RECEIVED	
<i>JUL 17 2003</i>	
BY: OLWR	
Top of Lap Pipe or Reduction in Casing	FEET
	IF TELESCOPED OR MORE THAN ONE SCREEN: USE BACK PAGE


I certify that the well was drilled, constructed and completed in accordance with all applicable Requirements of the Mississippi Department of Environmental Quality and/or the Mississippi Department of Health regulations and state laws.

Ala Medd 0563
Signature of Licensed Driller and License No.

July 14, 03
Date

If well telescopes please sketch and show depths.

GROUND LEVEL

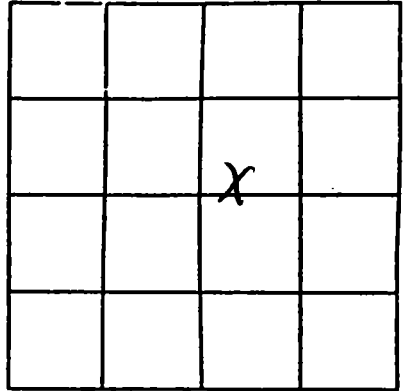

SECTION 8

Please indicate well location X.

Pump Capacity (GPM)	No. of Stages	Setting Depth
14	2	35 FT.

PUMP TEST

Well yielded 25 GPM with a drawdown of _____ ft. after _____ hours of pumping

LOG DATA

TYPE OF LOG RUN (Circle One): No Log Run, Electric, Gamma Ray, Density, Sonic, Neutron, Other (Describe) _____

Name of Organization Running Log

GEOLOGIC DATA (Office Use Only)

Surface Elev.	Geologic Unit	Unit Thickness	Depth to Top
Subs. SWL	Date	Analysis	Aquifer Test

Driller's Remarks

If more than one screen, show location of each on sketch.