

30-21-05-1

88-42-2.3

MISSISSIPPI DEPARTMENT OF ENVIRONMENTAL QUALITY

Office of Land and Water Resources

P. O. Box 10631

Jackson, MS 39289-0631

WATER WELL DRILLERS LOG

COUNTY WELL LOCATED  
**Jackson**

WELL NUMBER CODED  
**Q-460**

DATE WELL COMPLETED  
**Aug 8, 03**

PERMIT NUMBER  
**MSFW-11**

NAME OF DRILLING FIRM  
**8827 Boss Hoss, Inc**

**Baling**

NAME & MAILING ADDRESS OF LANDOWNER  
**FEB Disner**  
**1124 Oak St**  
**Ocean Springs**

Latitude:  
Longitude:

WELL LOCATION: SEC **19.7** TOWNSHIP **78<sup>th</sup> N** RANGE **7** **E**

DISTANCE **4** MILES DIRECTION **South** of NEAREST TOWN **Ocean Springs**

OTHER LANDMARK  
**St Andrews golf Course**

WELL PURPOSE: Home, Irrigation, Municipal, Industrial, Fish Pond, etc.  
**Home**

PUMP DATA

PUMP TYPE (Circle One):  
Submersible, Turbine,  Flowing Well, Other (Describe)

POWER TYPE (Circle One):  
 Electric, Tractor, Diesel, Gasoline, Butane, Other (Describe) **H/P**

DESCRIPTION OF FORMATIONS ENCOUNTERED	FROM	TO
<b>Brown sand</b>	<b>0-20</b>	
<b>clay</b>	<b>20-35</b>	
<b>sand</b>	<b>35-60</b>	
<b>clay</b>	<b>60-70</b>	
<b>sand</b>	<b>70-95</b>	

WELL DATA

Well Depth **95** Casing Diameter (in.) **2"** Casing Length (Ft.) **85**

Type of Casing **2"** Hole Depth **95** Depth to Static Water Level **10**

TYPE OF COMPLETION: (Circle One or More):  
Gravel Packed, Underreamed, Telescoped,  Natural Development, Open Hole, Other

WELL GROUTED TO A DEPTH OF **10** FEET  
Type Grout (circle one): Cement, Bentonite, or Mix

SCREEN DATA

Diameter - Inches **2"** Length - Feet **10'** Slot Size - Inches **.006**

Screen Type **PVC** Depth to Bottom - Feet **85-95**

**RECEIVED**

**SEP 02 2003**

**BY: OLWR**

Top of Lap Pipe or Reduction in Casing

FEET  IF TELESCOPED OR MORE THAN ONE SCREEN: USE BACK PAGE

I certify that the well was drilled, constructed and completed in accordance with all applicable Requirements of the Mississippi Department of Environmental Quality and/or the Mississippi Department of Health regulations and state laws.


**Al Mohd 0563**  
Signature of Licensed Driller and License No.

**Aug 26, 03**  
Date

Additional Information Required On Back

If well telescopes please sketch and show depths.

GROUND LEVEL

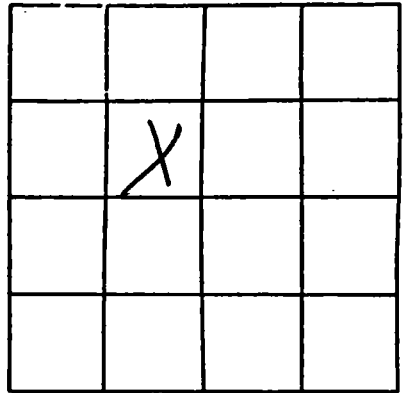

SECTION 7

Please indicate well location X.

Pump Capacity (GPM)	No. of Stages	Setting Depth
<u>14</u>	<u>2</u>	<u>40</u> FT.

PUMP TEST

Well yielded 25 GPM with a drawdown of \_\_\_\_\_ ft. after \_\_\_\_\_ hours of pumping

**LOG DATA**

TYPE OF LOG RUN (Circle One): No Log Run, Electric, Gamma Ray, Density, Sonic, Neutron, Other (Describe) \_\_\_\_\_

Name of Organization Running Log

**GEOLOGIC DATA (Office Use Only)**

Surface Elev.	Geologic Unit	Unit Thickness	Depth to Top
Subs. SWL	Date	Analysis	Aquifer Test

Driller's Remarks

If more than one screen, show location of each on sketch.