State W	ell Report	For Office Use Only	
	Part 1	For Office Use Only:	
Mississippi Departmen	t of Environmental Quality	Aquifer:	
Permit #: Office of Land	ermit #: Office of Land and Water Resources Well #: $\frac{Q - 542}{2}$		
	-un ('MStWAter Well SKV. P.O. Box 10031		
Jackson, in	961-5210	L. S. Elevation:	
(601)35	4-6938 (fax)	E-log #:	
State Law requires that this report be prepared by the driller in detail and filed with the Department within 30 days of completion of drilling of the well.			
Well Owner Information	Well	Location	
Owner Name_Michael Jenner		" Longitude: 085. 47. 601"	
Mailing Address: 770501d For + Bayourd.	Method of Lat/Long (circle or	ne): Conventional Survey, 36	
	USGS quad, Hand-held	GPS/ Survey-grade GPS	
Vancleave mis 395165 City State Zip Code	NE 1/2 NE 1/2 Sec 9	Twn 775 Rng R8W	
Telephone No. 200217 - 3794	Distance Direction Miles	Nearest Town of <u>Deean Spring</u>	
Well Data			
\frown			
Purpose of Well (circle one Home Industrial Public Supply Irrigation Fish Culture Other:			
Date well drilling started: 8-31-07 Date well drilling completed: 8-31-07			
If flowing, method of flow regulation: Valve <u>NA</u> Other (describe)			
Static Water Level: 30feet above or below (circle one) land surface Date measured: 8-31-07			
Method of Measurement (circle one) steel tape electric tape air line other:			
Hole depth: <u>195 FT</u> Well depth: <u>195 FT</u> Well grouted to a depth of <u>10</u> feet			
Type of grout (circle one): Cement Bentonite Mix			
Casing length: <u>185</u> feet Casing diameter: <u>2</u>	_inches Type of casing:	pvc	
Screen length: <u>10</u> feet Screen diameter: <u>2</u> inches Type of screen: <u>fvc</u>			
Screen slot size: . OC4 inches Setting depth: From feet to feet to			
Type of completion (circle all applicable): Gravel packed Underreamed Telescoped Open hole Natural Development			
Other (describe):			
Top of lap pipe or reduction in casing: NA feet. If telescoped or more than one screen, describe on back of page			
Logs run (circle all applicable): No log run Electric Gamma Ray Density Sonic Neutron Other:			
Name of organization running log(s): N/A			
certify that the well was drilled, constructed, and completed in a	ccordance with all applicable r	equirements of the Mississippi	
Department of Environmental Quality and/or the Mississippi Dep	and the second se		
Jack Ridgdell 0-472-	All M	liffue	
Print Name of Water Well Contractor and License No.	Signature of W	Vater Well Contractor	
	artment of Health regulations	requirements of the Mississippi and state laws. hilfun	

•

۰, ۲

٠

SEP 2.7 2007

Q-542

If well telescopes please sketch below and show depths.


Ground Level

 \cdot

•

Description of Formations Encountered	From	To
TOPSCIT Orunge Clay	13	iç,
White Coarse Sand Blueclay	40	46 168 195
Gray n Echimin Said		175
	_	
		\square

If more than one screen, show location of each on sketch

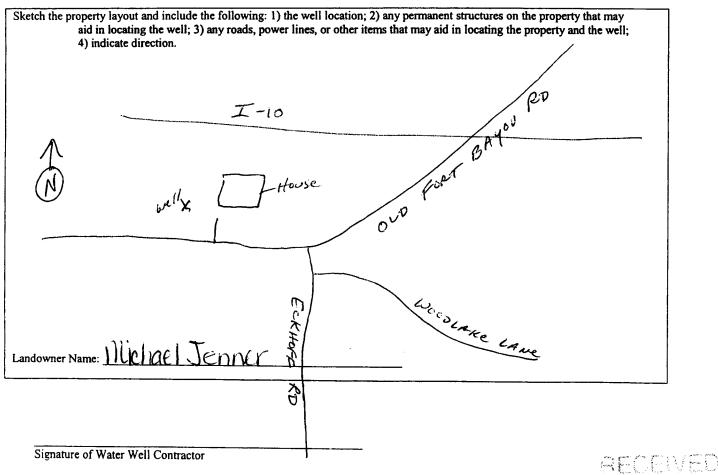

SPEZZ 2007 BY OLWR

STATE WELL REPORT				
County: JacksonMissi Permit #: Driller: Cast Water WellSRV . Date completed: 8-31-07	Part 2 'ump Installer's Completion Report sippi Department of Environmental Quality Office of Land and Water Resources P.O. Box 10631 Jackson, MS 39289-0631 (601)961-5210 (601)354-6938 (fax)			
This report should be prepared by the pump installer in detail and filed with the Department within 30 days of the				
installation of pump. Well Owner Information Owner Name: <u>Michael Jepner</u> Mailing Address: <u>7705 Cld FOrt Bay</u> <u>Vancleave Ms 39</u> City State Z Telephone No. <u>208</u> <u>217-3794</u>	XI Latitude: $30^{\circ} 27' 183''$ Longitude: $058^{\circ} 47' 60''$ $+$ Bayoukkd.Method of Lat/Long (circle one): Conventional Survey, USGS quad, Hand-held GPS) Survey-grade GPS $s 37565$ $NE \frac{14}{NE} \frac{NE}{4} Sec 9 Twn T75 Rng R8W$ DistanceDirectionNearest Town			
Pump Type Circle one Air Lift Jet Submet	Power Type Circle one sible Diesel Engine Gasoline Engine Natural Gas			
Bucket Piston Turbine Centrifugal Rotary Flowin Other (specify):	Horse Power Rating of Motor: <u>IHP</u> Setting Depth: <u>(CFT. Drop Pipe</u> feet			
Rated Pump Capacity:	Method of Measuring Water Level Circle one			
Static Water Level (A):Feet Below La Pumping Water Level (B):Feet Below La	Other (specify):			
Drawdown $[(B) - (A)]$: <u>NH</u> Feet Below La Test Pumping Rate: <u>S</u> , <u>S</u> Gallons F Duration of Pump Test (minimum 4 hours): <u></u>	er Minute Well yielded <u>8.5</u> GPM with a drawdown of			
I HEREBY CERTIFY that the above statements are true to the best of my knowledge. Jock Ridgclell 0-472 Jock Ridgclell 0-472 Jock Ridgclell 0-472 Print Name of Pump Installer and License No. (if applicable) Signature of Pump Installer SEF 2.7 2007				

.

.

· •

BY. OLWR