	State W	ell Report	For Office Use Only:
County: JACKSON		Part 1	
Permit #:	Mississippi Department Office of Land a	t of Environmental Quality nd Water Resources	$\frac{\text{Aquifer:}}{\text{Well #:}} = \frac{Q - 55}{2}$
Driller Dast Water Well SRV.	P.O. B	lox 10631	
Date drilling completed: $5 - 27 - 08$	Jackson, wi	S 39289-0631 961-5210	L. S. Elevation:
	(601) 354	4-6938 (fax)	E-log #:
State Law requires that this rep	ort be prepared by the	driller in detail and filed w	ith the Department within
30 days of completion of drilling Well Owner Inform	ation		Location
Owner Name Wesley Wi	nterstein Latitude: 30.28,09		Longitude: 08 47, 412
Mailing Address: QUAVE Rd. Method of Lat/Long (cir		Method of Lat/Long (circle or	ne): Conventional Survey, 2.5
	•		GPS, Survey-grade GPS
VID ACTORNIA M	S 205155		
City State Zip Code		$\frac{SE}{4} \frac{NW}{4} \sec 5 Twn T75 \operatorname{Rng} R7W$	
Telephone No. (2018) 392 - 30	00	Distance Direction Miles Sout74	Nearest Town of VANCLEAVE
	Weil D		
Purpose of Well (circle one) Home Ind	lustrial Public Supply	Irrigation Fish Culture	Other:
		vell drilling completed: 5-	
	.)		<u>u v u</u>
If flowing, method of flow regulation: Va		escribe)	5-17 08
Static Water Level: <u>5</u> feet al	bove or below (circle one) la	and surface Date measured:	5-21-00
Method of Measurement (circle one) s	teel tape electric tape	air line other:	
Hole depth: 187' Well de	pth: 187'	Well grouted to a depth of	<i>]O</i> feet
Type of grout (circle one): Cement	Bentonite Mix		
Casing length:feet Casin	ng diameter: 2	_inches Type of casing:	ONC
Screen length: 1 feet Scre	en diameter: 2	inches Type of screen:	DVC
Screen slot size: , 008 inches	Setting depth: From		187 feet
	• • • •		
Type of completion (circle all applicable):	-		hole Natural Development
Top of lap pipe or reduction in casing:	NHA feet. If teld	escoped or more than one scre	en, describe on back of page
Logs run (circle all applicable). No log ru	n) Electric Gamma Ray	Density Sonic Neutron	Other:
Name of organization running log(s):	1A		
I certify that the well was drilled, constr Department of Environmental Quality a			•
		ariment of Heanh Pegulations	s and state laws.
Jack Kidgdell ()-472		Kilder
Print Name of Water Well Contractor and	License No.	Signature of	Water Well Contractor CEIV RECEIV JUN 13 BY: 0
			REUP


Q-551

If well telescopes please sketch below and show depths.

Ground Level

Description of Formations Encountered	From	То
The Soll orange clay orange clay Blue clay Blue clay Blue clay Blue clay Blue clay	000000000000000000000000000000000000000	

If more than one screen, show location of each on sketch

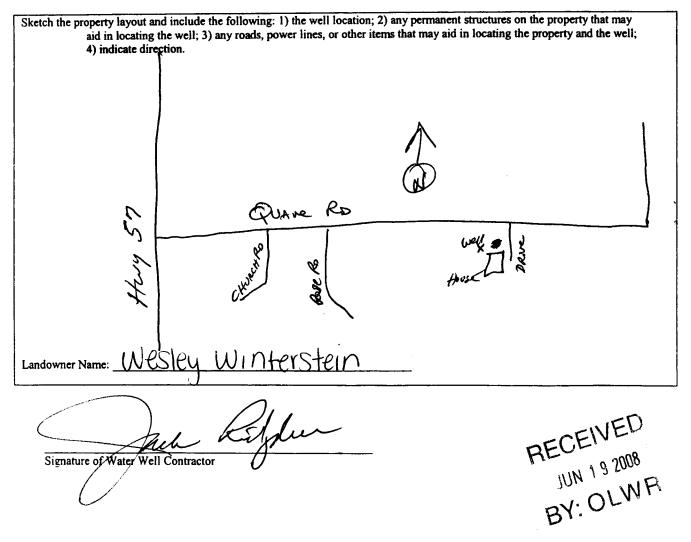

STATE W	ELL REPORT
County: JackSon Pump Installe Mississippi Departm Office of Land	Part 2 r's Completion Report ent of Environmental Quality d and Water Resources D. Box 10631 MS 39289-0631 Well #: <u>2-551</u>
5-27-08 (6)	MS 39289-0631 Well #: D1) 961-5210 Elevation: 354-6938 (fax) Elevation:
This report should be prepared by the pump installer in de	etail and filed with the Department within 30 days of the
installation of pump. Well Owner Information	Well Location
Owner Name: Wesley Winterstein	Latitude: <u>30°38'092"</u> Longitude: <u>08°43'413</u> "
Mailing Address: QUAVE Rd.	Method of Lat/Long (circle one): Conventional Survey,
Vancleave, MS 39565	USGS quad (Hand-held GPS,) Survey-grade GPS SE 1/4 NW 1/4 Sec 5 Twn T75 Rng R7W
City State Zip Code	Distance Direction Nearest Town
Telephone No. (258 392 - 3004	4 Miles South of Vancleave
	Power Type
Pump Type Circle one	Circle one
Air Lift Jet Submersible	Diesel Engine Gasoline Engine Natural Gas
Bucket Piston Turbine	Electric Motor Hand Tractor PTO
Centrifugal Rotary Flowing Well	Windmill Other (specify):
Other (specify):	Horse Power Rating of Motor:HP
Date Pump Installed: <u>5-30-08</u>	Setting Depth: (00Ft. drop pipe feet
Rated Pump Capacity: 8-5 Gallons Per Minute	Number of Stages:
Pump Test Data	Method of Measuring Water Level Circle one
Date Well Tested: <u>5-30-08</u>	Air Line Electric Measuring Line Steel Tape
Static Water Level (A): <u>35</u> Feet Below Land Surface Pumping Water Level (B): <u>N/A</u> Feet Below Land Surface	Other (specify):
Drawdown [(B) – (A)]: N/A Feet Below Land Surface	For flowing well, measured shut in head: NA feet
Test Pumping Rate: 8.5 Gallons Per Minute	Well yielded 24 GPM with a drawdown of
Duration of Pump Test (minimum 4 hours):	NA feet after NA hours of pumping
I HEREBY CERTIFY that the above statements are true to the bes <u>JACK Ridgdell</u> D-472 Print Name of Pump Installer and License No. (if applicable)	t of my knowledge. Signature of Pump Installer JUN 1920 JUN 1920 BY: OL
	an.

***** * 7

.