CLARA VI	ell Report			
	rt 1 For Office Use Only:			
County MCKOC Mississippi Department	of Environmental Quality Aquifer:			
Permit #: Office of Land an	d Water Resources $N = 553$			
	bx 10631 weil#			
	061-5210			
(601) 354	-6938 (fax) E-log #:			
State Law requires that this report be prepared by the c 30 days of completion of drilling of the well.	State Law requires that this report be prepared by the driller in detail and filed with the Department within			
Well Owner Information	Well Location			
Owner Name Charles MOOR	Latitude: 30 . 38 . 118 " Longitude 088. 42 . 275"			
Mailing Address: 5705 QUAVE Rd.	Method of Lat/Long (circle one): Conventional Survey,			
	USGS quad, Hand-held GPS Survey-grade GPS			
Ocean Spring MS 39565 City State Zip Code	<u>SE 1/2 NW 1/2 Sec 5 Twn 775 Rng R7 W</u>			
Telephone No. <u>208)</u> 875-9048	Distance Direction Nearest Town <u>4</u> Miles Source of VArcletue			
Weil Data				
Purpose of Well (circle one) Home Industrial Public Supply Irrigation Fish Culture Other:				
Date well drilling started: $(0 - 17 - 08)$ Date well drilling completed: $(0 - 17 - 08)$				
If flowing, method of flow regulation: Valve N/A Other (describe)				
Static Water Level: 35feet above (r below circle one) land surface Date measured: 6-17-08				
Method of Measurement (circle one) steel tape electric tape air line other:				
Hole depth: 187FT Well depth: 187FT Well grouted to a depth of 10 feet				
Type of grout (circle one): Cement Bentonite Mix				
Casing length: 177_feet Casing diameter: 2 inches Type of casing: PVC				
Screen length: 10 feet Screen diameter: 3 inches Type of screen: PVC				
Screen slot size: <u>CCC</u> inches Setting depth: From <u>177</u> feet to <u>187</u> feet				
Type of completion (circle all applicable): Gravel packed Underreamed Telescoped Open hole Natural Development				
Other (describe):				
Top of lap pipe or reduction in casing: feet. If telescoped or more than one screen, describe on back of page				
Logs run (circle all applicable): No log run Electric Gamma Ray Density Sonic Neutron Other:				
Name of organization running log(s): NA I certify that the well was drilled, constructed, and completed in accordance with all applicable requirements of the Mississippi				
Department of Environmental Quality and/or the Mississippi Department of Health regulations and state laws.				
JUCK Klagael U-4-12	pip puyou			
Print Name of Water Well Contractor and License No.	Signature of Water Well Contractor RECEIVED			
	JUL 18 2008			

BY: OLWR

- 553


If well telescopes please sketch below and show depths.

Grou

.

		Description of Formations Encountered	From	To
und Level		TOPSOIL		2
	[Blueclay	- a	12
		NhiteCoarse. Sand	-1S	BY I
	L L L L L L L L L L L L L L L L L L L	Drange + White Clay	-2	¥Ч
		Blueclay		
	4	ray fine Sand		% 3
		Blue Clay		ign .
	¢	stay coarsle Sand		LO A
	-			
		······································		
4				
1				
	[

If more than one screen, show location of each on sketch

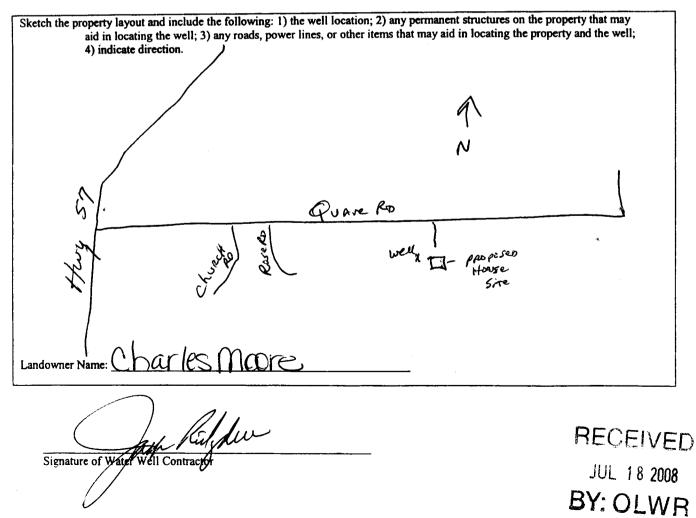

STATE WELL REPORT			
Pump Installer's Permit #:	art 2 For Office Use Only: art 2 For Office Use Only: art 2 Aquifer: art 2 Aquifer: art 2 Well #: b 201-5210 Elevation:		
This report should be prepared by the pump installer in detail and filed with the Department within 30 days of the installation of pump.			
Well Owner Information Owner Name: Charles MOOR Mailing Address: 5705 QUAVERA. <u>Ocean Springs Ms 39565</u> City State Zip Code Telephone No. 208) 875-9048	Well LocationLatitude: $\mathcal{DR}' 118''$ Longitude: $\mathcal{DR}' 42' 295''$ Method of Lat/Long (circle one): Conventional Survey,USGS quad, Hand-held GPSSurvey-grade GPSSurvey-grade GPSSE 1/2 NW 1/2 Sec 5 Twn T75 Rng R TWDistance Direction Nearest Town4 Miles South of VANdeAme		
Pump Type Circle one	Power Type Circle one		
Air Lift Jet Submersible	Diesel Engine Gasoline Engine Natural Gas		
Bucket Piston Turbine	Electric Motor Hand Tractor PTO		
Centrifugal Rotary Flowing Well Other (specify):	Windmill Other (specify): Horse Power Rating of Motor: Setting Depth \overrightarrow{O} FT. \overrightarrow{D} COP PiPetret Number of Stages:		
Pump Test Data Date Well Tested: $6 - 8 - 68$ Static Water Level (A): 35 Feet Below Land Surface Pumping Water Level (B): N/A Feet Below Land Surface Drawdown [(B) - (A)]: N/A Feet Below Land Surface Test Pumping Rate: 8 Gallons Per Minute Duration of Pump Test (minimum 4 hours): 4 hours	Method of Measuring Water Level Circle one Circle one Circle one Mathematical Electric Measuring Line Steel Tape Other (specify):		
I HEREBY CERTIFY that the above statements are true to the best of my knowledge. JOHN EIKINS 0-416P Jutture Print Name of Pump Installer and License No. (if applicable) Signature of Pump Installer			

.

×

ľ

٦

JUL 18 2008 BY: OLWR