County: Jackson Permit #: Driller Coast Water Well SRV Date drilling completed: 7-10-08 Permit #: Driller Coast Water Well SRV Date drilling completed: 601	Well	For Office Use Only: Aquifer:		
Mailing Address: Beasley Rd. Gaufier Ms 39553 City State Zip Code Telephone No. 208,348-8333	Method of Lat/Long (circle or USGS quad, Hand-held	$\frac{9000}{\text{GPS}}$ Survey-grade GPS $\frac{7}{1}$ Twn $\frac{725}{2}$ Rng $\frac{874}{2}$ Nearest Town		
Weil I	Data			
Purpose of Well (circle one) Home Industrial Public Supply Irrigation Fish Culture Other:				
	accordance with all applicable partment of Health regulation Opck Rid	een, describe on back of page Other: requirements of the Mississippi		

* *

AUG 9 8 2008 BY: OLVV R


Q - 554

If well telescopes please sketch below and show depths.

Ground Lev

evel	Description of Formations Encountered TOPSOIL BILLE CLAY Brown Coalise Sand 1314e CLAY Gray Medium to Coalise San	From To 72 1/3 72 1/3 72 1/3
	Filleclay Gray Medium to Centse Sand	

If more than one screen, show location of each on sketch

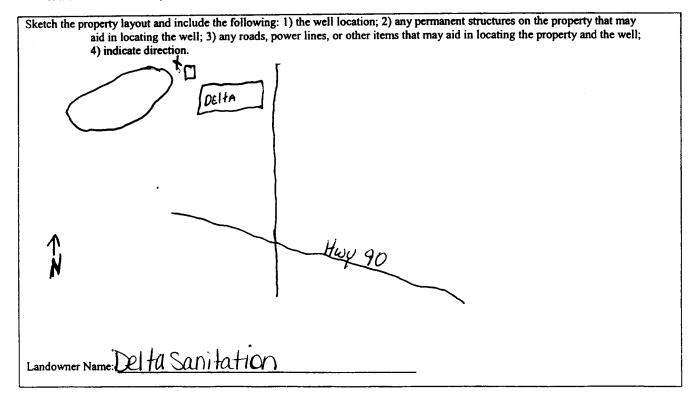

k Ridgol 172ture of Water Well Contractor

Sign

RECEIVED AUG 98 2008 BY: OLWR

	STATE WELL REPORT				
County: JOCKSON Permit #: DrillerCOSt Watter WellSRV , Date completed:O	Part 2 Pump Installer's Completion Report Mississippi Department of Environmental Quality Office of Land and Water Resources P.O. Box 10631 Jackson, MS 39289-0631 (601) 961-5210 (601) 354-6938 (fax)		For Office Use Only: Aquifer: Weil #:		
This report should be prepared by th installation of pump.	e pump installer in deta	il and filed with the Departmen	it within 30 days of the		
Well Owner Informat			Location		
Owner Name: Delta Sanitati	100 Latitude 3034'16		Longitude 28° 39′ 994″		
Mailing Address: Beasley Rd			one): Conventional Survey,		
			Hand-held GPS, Survey-grade GPS		
Gaufier Ms City State	Ms 39553 N/E ½ 5/E ¼ Sec_ State Zip Code Distance Direction		7 Twn T75 Rng R74) Nearest Town Gautier		
Telephone No. $(000346 - 800)$	<u></u>				
Pump Type Circle one			rer Type rele one		
Air Lift Jet (Submersible	Diesel Engine Gasoline	e Engine Natural Gas		
Bucket Piston	Turbine (Electric Motor Hand	Tractor PTO		
Centrifugal Rotary	Flowing Well	Windmill Other (s	specify):		
Other (specify):	-	Horse Power Rating of Motor:	3HP		
Date Pump Installed: 7-11-08		Setting Depth: 100FT. Droppipeteet			
Rated Pump Capacity: 85	Gallons Per Minute	Number of Stages:	• • •		
Pump Test Data	······································	Method of Mea	suring Water Level		
Date Well Tested: 7-11-08			cle one		
		Air Line Electric Meas	uring Line Steel Tape		
	Below Land Surface	Other (specify):			
	Below Land Surface		Alla		
Drawdown [(B) – (A)]: N/A Feet		For flowing well, measured shu	7		
Test Pumping Rate: <u>85</u>			$_{A}$ $/_{A}$ GPM with a drawdown of		
Duration of Pump Test (minimum 4 hours):	<u>12</u> hours	N/A feet after	N/A hours of pumping		
I HEREBY CERTIFY that the above statements are true to the best of my knowledge. JOCK RIdgdell 0-472 Print Name of Pump Installer and License No. (if applicable) Print Name of Pump Installer					

۲

--

•

.

406 18 2008 BY: OLWR