Rut 2 never received 31	·		For Office Use Only:
County: Jackson	Part 1 Mississippi Department of Environmental Quality		Aquifer:
Permit #:	Office of Land and	Water Resources	D Cra
A	P.O. Box		Weil #: 0-337
Driller COSt Water Wellsey	Jackson, MS		L. S. Elevation:
Date drilling completed:8-08_	(601) 96 (601) 354-6		E-log #:
		-	
State Law requires that this repo	ort be prepared by the dri	iller in detail and filed w	ith the Department within
30 days of completion of drilling Well Owner Informa		Well	Location
Owner Name Mississippi Sand	Hill Crane Refuger	atitudes 30 . 25.43	" Longitude: 088. 41 . 22
•	-		
Mailing Address: 7200 Crane	<u>, Lane</u> M	lethod of Lat/Long (circle or	ne): Conventional Survey,
		USGS quad, Hand-held	GPS Survey-grade GPS
Grantier Me :	39553	SEV SE 1/4 Sec 15	Twn 775 Rng R 74
City Stat	te Zip Code	SW NE 21	
Telephone No. (288) 497-63	1 ^D	Vistance Direction	of Gaurica
-	Well Dat	2	
Purpose of Well (circle one) Home Ind	ustrial Public Supply Ir	rigation Fish Culture	Other:
Date well drilling started:	Date well	drilling completed:	18-08
If flowing, method of flow regulation: Val	. 14		
	•		
Static Water Level:feet ab	ove or below circle one) land	surface Date measured:	11-18-08
Method of Measurement (circle one) st	teel tape electric tape	air line other:	
Hole depth: 53 FT Well dep	oth: 53FT	Well grouted to a depth of	IO feet
	\frown		
	Bentonite Mix		• •
Casing length: <u>48</u> feet Casir	ng diameter:ir	nches Type of casing:	pvc
Screen length: 5 feet Scree	en diameter: 4 i	nches Type of screen:	PVC
		10	
) <u> feet</u>
Type of completion (circle all applicable):	Gravel packed Underreat	med Telescoped Open	hole Natural Development
	Other (describe):		
Top of lap pipe or reduction in casing:	NA feet. If telesc	oped or more than one scre	en, describe on back of page
Logs run (circle all applicable) No log run	`		10
	NA		
Name of organization running log(s):		rdance with all applicable	requirements of the Mississipp
Name of organization running log(s): I certify that the well was drilled, constru	ucted, and completed in acco	n dauce who an applicable	
I certify that the well was drilled, constru			
I certify that the well was drilled, constru			

.

۶


DEC 1 5 2008 BY: OLWR

If well telescopes please sketch below and show depths.

Ground Level

		E
d Level	 Description of Formations Encountered	From To
	Graviclay White Coarse sand Blue Clay White Coarse Sand	16 23 33 41 41 53
l l		

If more than one screen, show location of each on sketch

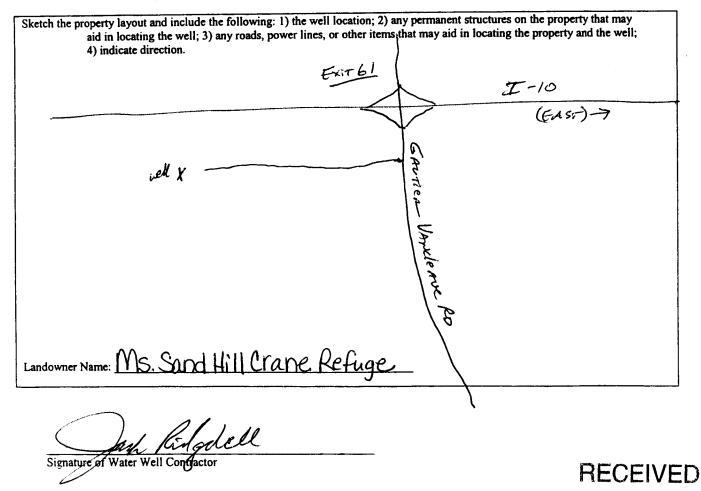

DEC 1 5 2008 BY: OLWR