| State W | ell Report | | | |
|--|--|---|--|--|
| P Tarkson P | art 1 | For Office Use Only: | | |
| Mississippi Departmen | t of Environmental Quality nd Water Resources | Aquifer: | | |
| | Box 10631 | Weil #: | | |
| Juckboli, IV | IS 39289-0631 | L. S. Elevation: $\cancel{59.3}$ | | |
| | 961-5210 4-6938 (fax) | / E-log #: | | |
| State Law requires that this report be prepared by the driller in detail and filed with the Department within | | | | |
| State Law requires that this report be prepared by the 30 days of completion of drilling of the well. | | | | |
| Well Owner Information | | Location | | |
| Owner Name Karen Roberts | Latitude: <u>30 • 32 • 800</u> 48 | " Longitude: 08 43 8 3" | | |
| Mailing Address: 7335 Fountain Dieu Rd. | Method of Lat/Long (circle on | e): Conventional Survey, | | |
| | USGS quad, Hand-held | GPS, Survey-grade GPS 7W | | |
| Ocean Springs, MS 39504 City State Zip Code | SE 1/2 ME y Sec / (| O Twn T85 Rng ABW | | |
| Telephone No. (228) 818 - 9000 | Distance Direction | Nearest Town of <u>Ocean Spentys</u> | | |
| Well I | Data | | | |
| Purpose of Well (circle one) Home) Industrial Public Supply Irrigation Fish Culture Other: | | | | |
| Date well drilling started: <u>5-8-07</u> Date well drilling completed: <u>5-8-07</u> | | | | |
| If flowing, method of flow regulation: Valve <u>NA</u> Other (describe) | | | | |
| Static Water Level: 45 feet above or below (circle one) land surface Date measured: 5-8-07 | | | | |
| Method of Measurement (circle one) steel tape electric tape air line other: | | | | |
| Hole depth: <u>357'</u> Well depth: <u>357'</u> Well grouted to a depth of <u>10</u> feet | | | | |
| Type of grout (circle one): Cement Bentonite Mix | | | | |
| Casing length: <u>347</u> feet Casing diameter: <u>2</u> inches Type of casing: <u>PVC</u> | | | | |
| Screen length: <u>10</u> feet Screen diameter: <u>2</u> inches Type of screen: <u>DVC</u> | | | | |
| Screen slot size: <u>cCCC</u> inches Setting depth: From | <u>347</u> feet to <u>36</u> | 57 feet | | |
| Type of completion (circle all applicable): Gravel packed Underreamed Telescoped Open hole Natural Development | | | | |
| Other (describe): | | | | |
| Top of lap pipe or reduction in casing:feet. If telescoped or more than one screen, describe on back of page | | | | |
| Logs run (circle all applicable) No log run Electric Gamma Ray Density Sonic Neutron Other: | | | | |
| Name of organization running log(s): N//A I certify that the well was drilled, constructed, and completed in accordance with all applicable requirements of the Mississippi | | | | |
| Department of Environmental Quality and/or the Mississippi Department of Health regulations and state laws. | | | | |
| Taak Ridadall O 1100 | | RII | | |
| Print Name of Water Well Contractor and License No. | - Ham | Har Will Comments of the second | | |
| This mane of water wen Contractor and License No. | Signature of V | water well Compactor | | |

, [,] ,

MAY 3 1 2007 BY: OLWR


N-1017 \$593

If well telescopes please sketch below and show depths.

Ground Level

| - | Description of Formations Encountered TOP SOII Orange Clay | From | F₀ 1050 |
|---|--|-----------|-------------------|
| | Blue clay wistreaks of sand Gray medium sand | 83 343 | <u>343</u> 357 |
| | | | |
| | | | |
| | | | |
| | | | |

If more than one screen, show location of each on sketch

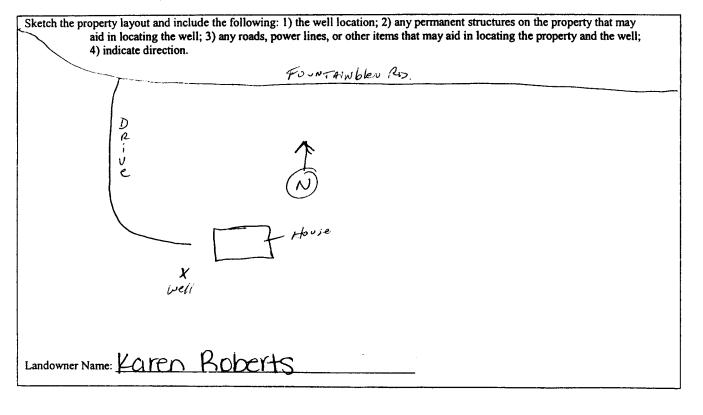

Signature of Water Well Contractor

MAY 3 1 2007 BY: OLWR

| | STATE W | ELL REPORT | | |
|--|---|---|--|--|
| County: JACKSON Permit #: Driller Date COAST WATER WELLSRV Date completed: _5-8-07 | Part 2 Pump Installer's Completion Report Mississippi Department of Environmental Quality Office of Land and Water Resources | | For Office Use Only: Aquifer: \$\overline{593}\$ Well #: | |
| Date completed: <u>5 6 7 1</u> | (601)3 | 54-6938 (fax) | Elevation: | |
| This report should be prepared by installation of pump. | the pump installer in det | ail and filed with the Departme | nt within 30 days of the | |
| Well Owner Informa | ation | Wel | Well Location | |
| Owner Name: Karen Robo | erts | Latitude: 30°22'800 | "Longitude: <u>088° 43'84</u> 3 | |
| Mailing Address: 7335 Founta | inbeu Rd. | Method of Lat/Long (circle or | e): Conventional Survey, | |
| | | USGS quad Hand | I-held GPS, Survey-grade GPS | |
| Ocean Springs / City State | $\frac{NS 39565}{\text{Zip Code}} = \frac{SE}{SW} \frac{NE}{NW}$ Distance Direction | | Sec \underline{W} Twn $\underline{785}$ Rng $\underline{889}$ Rng $\underline{899}$ Rng $\underline{799}$ Rng \underline | |
| Telephone No. (2019 818 - 900 | 00 | <u>3</u> Miles SE of Ocean Springs | | |
| Ритр Туре | | | wer Type | |
| Circle one | | C | ircle one | |
| Air Lift (Jet) | Submersible | Diesel Engine Gasolin | e Engine Natural Gas | |
| Bucket Piston | Turbine | Electric Motor Hand | Tractor PTO | |
| Centrifugal Rotary | Flowing Well | | (specify): | |
| Other (specify): | Dther (specify): Date Pump Installed:5-9-07 | | Horse Power Rating of Motor: 1 HP | |
| Date Pump Installed: 5-9-0 | | | Setting Depth: LOD FF . dY OP DiP Geet | |
| Rated Pump Capacity:7 | _Gallons Per Minute | Number of Stages: | 2 | |
| Pump Test Data | | Method of Measuring Water Level Circle one | | |
| Date Well Tested: <u>5-9-07</u> | | | | |
| Static Water Level (A): <u>45</u> Fee | t Below Land Surface (| Air Line Electric Measuring Line Steel Tape | | |
| Pumping Water Level (B): NA Feet | Below Land Surface | Other (specify): | | |
| Drawdown [(B) - (A)]: <u>NA</u> Fee | t Below Land Surface | For flowing well, measured sh | ut in head: <u>NA</u> feet | |
| Test Pumping Rate:7 | _Gallons Per Minute | Well yielded | _GPM with a drawdown of | |
| Duration of Pump Test (minimum 4 hours) | : hours | N/A_feet after_ | N/Ahours of pumping | |
| I HEREBY CERTIFY that the above stater <u>JACK RIAGOEII</u> Print Name of Pump Installer and License | -472 | of my knowledge. | liftur PECEIVI | |
| | | 0 | MAY 3 1 20 | |
| | | | BY: OLW | |

,

•