County: JACKSON Permit #: Office of Land a Driller: CCAST WATER WILLSRV. Date drilling completed: 11-27-07 (601)		I Location
Clean Springs, M.S. 39564 City State Zip Code Telephone No. (228) (123-21793	NE 1/4 NE 1/4 Sec X	Twn <u>T 85</u> Rng <u>R8</u> W Nearest Town
Weil	Data	
Date well drilling started:	and surface Date measured: air line other: Well grouted to a depth of inches Type of casing: inches Type of screen: 345feet to	$\frac{1-37-07}{11-37-07}$ $\frac{10}{10}$ feet $\frac{9VC}{355}$ feet hole Natural Development
Top of lap pipe or reduction in casing:feet. If te Logs run (circle all applicable) No log run Electric Gamma Ray Name of organization running log(s): NA I certify that the well was drilled, constructed, and completed in a Department of Environmental Quality and/or the Mississippi Dep Track Quadrall C-UT2	Density Sonic Neutron	Other:
Print Name of Water Well Contractor and License No.		Water Well Commet DEOFIN/FF
Print Name of Water Well Contractor and License No.	Signature of	
		DEC 2 6 2007

•

۰.


BY:	0		W	P
-----	---	--	---	---

If well telescopes please sketch below and show depths.

٩

Ground Level

If more than one screen, show location of each on sketch

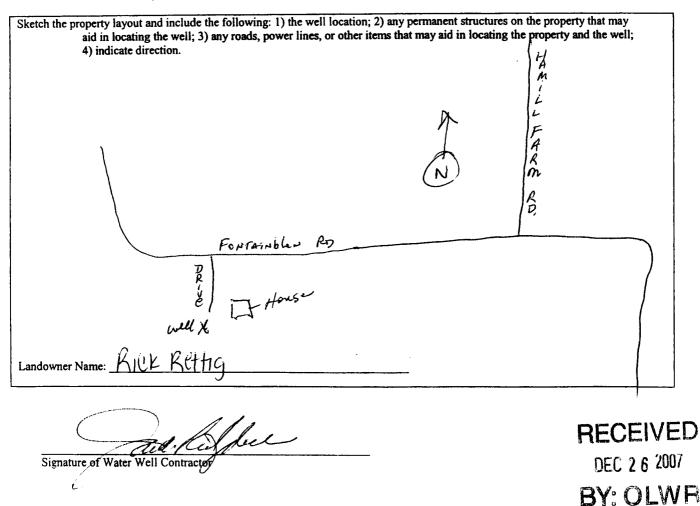

			ELL REPORT		
County: JACKS	m	Pump Installe	Part 2 r's Completion Report	For Office Use Only:	
Permit #:		Mississippi Departm	ent of Environmental Quality d and Water Resources	Aquifer: ϕ 594	
DrillerCCast We	ater Wellsk	P.O	. Box 10631 , MS 39289-0631	Well #: 4024 Elevation:	
Date completed:	-	(60	1)961-5210 354-6938 (fax)		
			tail and filed with the Departm	ent within 30 days of the	
installation of p	ump.				
Well Owner Information			Well Location Latitude 30°32' 8 32'' Longitude: 088''43' 7(64		
Owner Name: <u>Ri(</u>	L KETTY	malal in 12 d			
Mailing Address: <u>1</u>	XC9 Fountainbleu Rd.		Method of Lat/Long (circle one): Conventional Survey,		
			USGS quad, (Hand-held GPS) Survey-grade GPS		
<u>((')</u> Cit	unsprings	$\frac{115 37509}{\text{e}}$	$\frac{ME}{5} \frac{ME}{N} \frac{ME}{N} \frac{ME}{V} \frac$		
Telephone No. (2)	5423-27	93	_2 Miles SE of Crean Springs		
	Pump Type Circle one			wer Type	
A. 1.0	\sim	S-b-weekile.			
Air Lift	(Jet)	Submersible		ne Engine Natural Gas	
Bucket	Piston	Turbine	Electric Motor Hand	Tractor PTO	
Centrifugal		Flowing Well		(specify):	
	1-28-07	· · · · · · · · · · · · · · · · · · ·	Horse Power Rating of Motor		
Date Pump Installed:	11-28-01	·	Setting Depth: SOFT.L		
Rated Pump Capacity	88	Gallons Per Minute	Number of Stages:	8	
	Pump Test Dat	2		asuring Water Level	
Date Well Tested:	11-38-0	7			
Static Water Level (A):Feet Below Land Surface		Air Line Electric Measuring Line Steel Tape			
Pumping Water Level	(B): <u>NA</u> Fe	et Below Land Surface	Other (specify):		
Drawdown [(B) - (A)]]: <u>NJA</u> Fe	et Below Land Surface	For flowing well, measured sh	nut in head: <u>N/A</u> feet	
	' -	Gallons Per Minute	Well yielded	17	
		s): <u>51/2</u> hours		$\frac{N}{4}$ hours of pumping	
	that the above state	ements are true to the best	of my knowledge.		
I HEREBY CERTIFY	•	Ω_{-}	Amellin	RECEIVE	