

STATE WELL REPORT

Part 1

Driller's Log

Mississippi Department of Environmental Quality
Office of Land and Water Resources
P.O. Box 2309
Jackson, MS 39225-2309
(601)961-5210
(601)360-0535 (fax)

For Office Use Only:

Well #: 0614
Aquifer:
E-Log #:

County: Jackson
Permit #:
Driller: Coast Water Wells Svc
Date drilling completed: 3-10-16

State Law requires that this report be prepared by the license holder responsible for the work and filed with the Department at the above address within 30 days of completion of drilling of the well or borehole.

Well Owner Information (Landowner if borehole is not for a water well)
Owner Name: Pat Kennedy
Mailing Address: West Belle Fontaine Beach Drive
Ocean Springs, MS 39564
Telephone No. 228 233-4391
Well or Borehole Location
Latitude: 30°20'34.08" Longitude: 088°43'5.52"
Method of Lat/Long (check one): Conventional Survey
USGS quad 5E SW 1/4 SW 1/4, Sec 18 T 8S R 7W
3 1/2 Miles SW of Gautier

Well / Borehole Data
Date drilling started: 3-10-16 Date drilling completed: 3-10-16 Hole depth: 125 FT Hole diameter: 2"
Location of the source of any surface water used for drilling: N/A
Method of dosing and volume of Chlorine used in drilling and development: 1 GAL Per 1000 Drilling 2 GAL in Well
Logs run (circle all applicable): No log run
Name of organization running log(s):
Purpose of borehole (circle one): Water Well
Purpose of Well (circle all applicable): Home
Other (describe):
If a flowing well, method of flow regulation: Valve
Static Water Level: 0 feet [above or below] land surface Date measured: 3-10-16
Method of measurement (circle one): Air line
Well depth: 125 FT Well grouted to a depth of: 10 feet Type of grout (circle one): Neat Cement Bentonite Mix
Casing length: 115 feet Casing diameter: 2 inches Type of casing: PVC
Screen length: 10 feet Screen diameter: 2 inches Type of screen: PVC
Screen slot size: .006 inches Setting depth: From 115 feet to 125 feet
Type of completion (circle all applicable): Natural Development
Other (describe):
Top of lap pipe or reduction in casing: N/A feet

If telescoped or more than one screen, describe on next page

Received


APR 08 2016

County: Jackson
Permit #: _____

For Office Use Only:
Well #: 0614

The sketch below only required for water wells

If well telescopes, show depths on sketch.

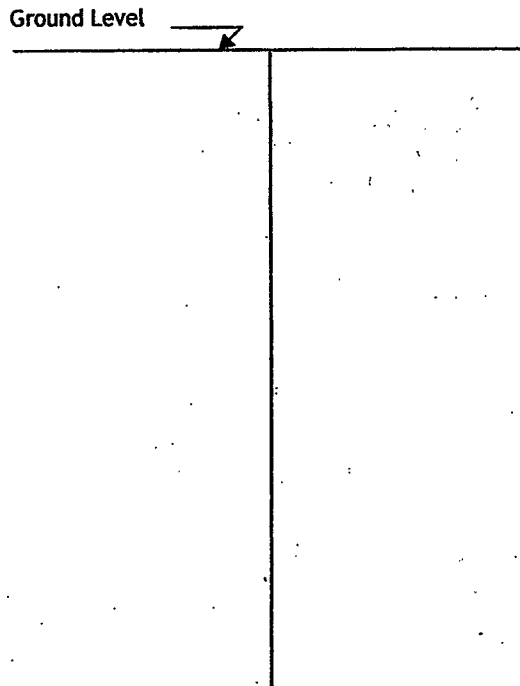

Description of formations encountered must be provided for all wells and boreholes, unless specifically exempted by regulations

Description of Formations Encountered	From (depth) Ground level	To (depth)
White coarse sand		15
Blue clay	15	100
White coarse sand	100	125

If more than one screen, show location of each on sketch

- Sketch the property layout and include the following:
- 1) the well location
 - 2) any permanent structures on the property that may aid in locating the well
 - 3) any roads, power lines, or other items that may aid in locating the property and the well
 - 4) north arrow

note: Well on existing power lot
no House - NO power
well only no pump.
He plans to sell this lot.



Received
APR 08 2016
By OLWR

West Bellefleurine Beach Drive
X well

Landowner Name: Pat Kennedy

I HEREBY CERTIFY that the well/borehole was drilled, constructed, and completed in accordance with all applicable requirements of the Mississippi Department of Environmental Quality and the Mississippi Department of Health regulations, if applicable, and state laws.

Jack Ridadell 0-472 3/10/16
Print Name of Responsible Licensee and License No. Date

Jack Ridadell
Signature of Licensee