

Jackson

STATE WELL REPORT

Part 1

Driller's Log

Mississippi Department of Environmental Quality
Office of Land and Water Resources
P.O. Box 2309
Jackson, MS 39225-2309
(601)961-5210
(601)360-0535 (fax)

For Office Use Only:

Well #: 0627
Aquifer:
E-Log #:

County: Harrison
Permit #: 0239
Driller: MCB: Pump Well
Date drilling completed: 4-19-17

State Law requires that this report be prepared by the license holder responsible for the work and filed with the Department at the above address within 30 days of completion of drilling of the well or borehole.

Well Owner Information (Landowner if borehole is not for a water well)
Owner Name: Garrett Garcia
Mailing Address: 6925 Belle Fontaine Drive Lot 25 Ocean Springs MS 39564
Telephone No. (228) 332-3601
Well or Borehole Location
Latitude: 30° 20' 36.47" Longitude: 88° 43' 33.58"
Method of Lat/Long (check one): Conventional Survey
USGS quad, Hand-held GPS, Survey-grade GPS
SE 1/4 SW 1/4, Sec 27 T 85 R 7
10.3 Miles East of Gautier
(Distance) (Direction) (Nearest Town)

Well / Borehole Data
Date drilling started: 4-17-17 Date drilling completed: 4-19-17 Hole depth: 240 Hole diameter: 4x2
Location of the source of any surface water used for drilling: water well
Method of dosing and volume of Chlorine used in drilling and development: NA
Logs run (circle all applicable): No log run Electric Gamma Ray Density Sonic Neutron Other:
Name of organization running log(s): NA
Purpose of borehole (circle one): Water Well Geotechnical/Geological Investigation Ground Source Heat Pump Seismic Survey Other (describe)
If drilling is not related to water well construction, skip the remainder of this block

Purpose of Well (circle all applicable): Home Industrial Public Supply Irrigation Fish Culture
Other (describe):
If a flowing well, method of flow regulation: Valve Other (describe) Back wash valve
Static Water Level: 5 feet [above or below] land surface Date measured: 4-21-17
Method of measurement (circle one): Steel tape Electric tape Air line Other (describe):
Well depth: 240 Well grouted to a depth of: 10 feet Type of grout (circle one): Neat Cement Bentonite Mix
Casing length: 220 feet Casing diameter: 4x2 inches Type of casing: PVC
Screen length: 20 feet Screen diameter: 2 inches Type of screen: PVC
Screen slot size: .006 inches Setting depth: From 220 feet to 240 feet
Type of completion (circle all applicable): Gravel packed Underreamed Open hole Natural Development
Other (describe):
Top of lap pipe or reduction in casing: 200 feet

If telescoped or more than one screen, describe on next page

RECEIVED

Form OLWR/SWR 41A (4/13)

BY OLWR

[The page contains extremely faint and illegible text, likely bleed-through from the reverse side of the document. The text is scattered across the page and does not form any recognizable words or sentences.]

Jackson

# STATE WELL REPORT

## Part 2

### Pump Installer's Completion Report

Mississippi Department of Environmental Quality  
Office of Land and Water Resources

P.O. Box 2309  
Jackson, MS 39225-2309  
(601)961-5210  
(601) 360-0535 (fax)

### For Office Use Only:

Well #: 0627

Aquifer: \_\_\_\_\_

County: HARRISON  
 Permit #: 0239  
 Driller: Mc Gill pump + well  
 Date completed: 4-19-17  
 Copy information from block on Part 1

*This part of the report must be completed by a licensed water well contractor or a licensed pump installer. A copy of Part 1 of the report must be attached and both parts filed with the Department at the above address within 30 days of well completion.*

Well Owner Information	Well Location
Owner Name: <u>Garrett Garcia</u>	Latitude: <u>30°20'36.47"</u> Longitude: <u>88°43'33.58"</u>
Mailing Address: <u>6925 Belle Fontaine Drive Lot 25</u>	Method of Lat/Long (check one): Conventional Survey _____, Hand-held GPS <input checked="" type="checkbox"/> , Survey-grade GPS _____
<u>ocean springs ms 39564</u>	USGS quad _____, Sec. <u>32</u> T <u>8S</u> R <u>7W</u>
City _____ State _____ Zip Code _____	<u>10.3</u> Miles <u>East</u> of <u>Gulfier</u>
Telephone No. <u>(228) 332-3601</u>	(Distance) (Direction) (Nearest Town)

**Pump Type (circle one)**  
 Submersible Turbine Air Lift Centrifugal Flowing Well Jet Piston Rotary Other (describe): \_\_\_\_\_  
 Date Pump Installed: 4-21-17 Rated Pump Capacity: \_\_\_\_\_ Gallons Per Minute  
 Is This Pump (circle one):  New Repaired Replacement

**Power Type (circle one)**  
 Electric Diesel Gasoline Natural Gas Tractor PTO Windmill Other (describe): \_\_\_\_\_  
 Horse Power Rating of Motor: 1 h.p. Setting Depth: 40 feet Number of Stages: 7

**Pump Test Data for Non Flowing Well**  
 Date Well Tested: 4-19-17 Duration of Pump Test (minimum 4 hours): 4 hours  
 Static Water Level (A): 5 Feet Below Land Surface Pumping Water Level (B): 40 Feet Below Land Surface  
 Drawdown [(B) - (A)]: 0 Feet Below Land Surface Test Pumping Rate: 40 Gallons Per Minute  
 Method of measurement (circle one):  Steel tape Electric tape Air line Other (describe): \_\_\_\_\_

**Pump Test Data for Flowing Well** N/A  
 Measured shut in head: \_\_\_\_\_ feet.  
 Well yielded \_\_\_\_\_ GPM with a drawdown of \_\_\_\_\_ feet after \_\_\_\_\_ hours of pumping

**Meter Installation** N/A  
 Meter Manufacturer: \_\_\_\_\_ Meter Serial Number: RECEIVED  
 Meter Model Number/Name: \_\_\_\_\_ Type of Meter: MAY 22 2017  
 Totalizer Register Unit and Multiplier Factor (AF x .001, gal x 1000, etc): \_\_\_\_\_  
 Installation Date: \_\_\_\_\_ Meter installed by: BY OIWR  
 Is This Meter (circle one): New Repaired Replacement  
*Important: By submitting the above information you are certifying that this meter was installed to manufacturer standards. For agricultural wells, a list of approved meters is on the MDEQ website.*

I HEREBY CERTIFY that the above statements are true to the best of my knowledge.  
Michael McMillan #0239 5/12/17 [Signature]  
 Print Name of Pump Installer and License No. (if applicable) Date Signature of Pump Installer

The first part of the document discusses the importance of maintaining accurate records of all transactions. It emphasizes that every entry should be supported by a valid receipt or invoice. This ensures transparency and allows for easy verification of the data.

In the second section, the author outlines the various methods used to collect and analyze the data. This includes both primary and secondary data collection techniques. The primary data was gathered through direct observation and interviews with key personnel. Secondary data was obtained from existing reports and databases.

The third section details the results of the data analysis. It shows a clear trend of increasing activity over the period studied. The data indicates that the most significant changes occurred in the latter half of the year. These findings are supported by statistical analysis and visual representations of the data.


Finally, the document concludes with a series of recommendations based on the findings. It suggests that the current procedures should be reviewed and updated to reflect the latest trends. Additionally, it recommends that further research be conducted to explore the underlying causes of the observed changes.



Interstate 10 exit 57

0627

Ganlier/VanCleave

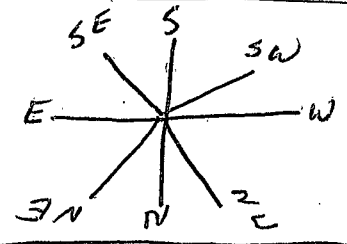

Hwy 57

Hwy 90E



village circle

village circle

Main St

Belle Fontaine Dr

metal fence

metal pole

gate

6925 Belle Fontaine Drive

concrete pillar wall X

Fence

RECEIVED  
MAY 22 2017  
BY OLWR