

2000  
2-8-64

WATER WELL DRILLERS LOG

Date: 2-8, 1964, Driller: H.O. Ridgell County Jackson  
(Name)

(1) Owner of Land: D.B. Flurry  
(Name)  
Hunter, Miss.  
(Address)

(2) Location: 1/4, 1/4, Sec. 0 T. 7 R. 7  
6 miles West of Langdale  
(distance) (direction) (Near Town)

(3) Topography:  (Level)  
(Hilly) (Flat)

(4) Purpose of Well: Home  
(Domestic Irrigation) (Municipal, Industrial, Other)

Description & Color of Materials Sand, Clay, Red Clay, Shell, etc.	Thick- ness Feet	Depth Feet
Clay	6	6
Thin Red sand	10	16
Blue Clay	84	100
Sand Medium coarse	10	110

Information upon completion of well:

(1) Diameter 1 1/4 inches.

(2) Total Depth 110 feet. 105


(3) Water Level 16 feet below top of ground.

(4) Cased to -, Size -

(5) Screen: Size 1 1/4", Length 5'

(6) Were any formations sealed against pollution?  
no.

If YES depth of formation \_\_\_\_\_  
Why \_\_\_\_\_  
Drillers Remarks: \_\_\_\_\_

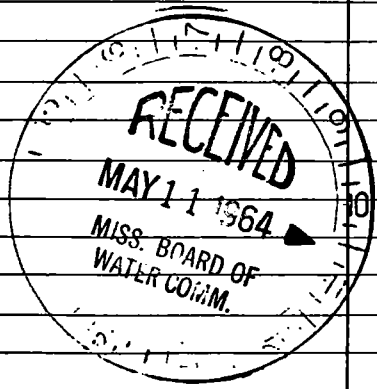

Well No.

(Use Back Side)

