

JACKSON
 0 7001
 3-68

MISSISSIPPI
 BOARD OF WATER COMMISSIONERS
 416 North State Street
 Jackson, Mississippi 39201

WATER WELL DRILLERS LOG

3-5-68 date well completed
 COAST WATER WELL SERVICE firm name
 JACKSON county well located

LANDOWNER LESLIE NELSON
 (Justice of Peace)

FOUNTAINBLEAU, MISS
 (mailing address)


WELL LOCATION:
 sec. 19 T-8 S. R-7 E.
5 miles (distance) SE (direction) of Spring (nearest town)

WELL PURPOSE: Camp
 (home, irrigation, municipal, industrial)

WELL COMPLETION DATA:

- (1) diameter (inches) 2"
- (2) total depth (feet) 609'
- (3) static water level (feet) 105' ^{below} / _{above} top of ground.
- (4) casing GALV. (material), 589 ft. (depth)
2" (size) if telescope see back.
- (5) screen 20 ft. (length), 589 ft. (depth to top)
2" (size), STAINLESS STEEL (material)
- (6) pump 1/2 (HP), 7 (yield gpm)
Elect (type power)
- (7) electric log NO (yes or no)
 (organization running log)
- (8) how well bottom plugged 2" BACK
WASH VALVE

description of formations encountered	from	to
COARSE SAND	0	108
BLUE-GRAY CLAY	100	180
MED. SAND	180	213
BLUE-GRAY Clay	213	300
SANDY SHALE	300	320
FINE SAND	320	328
Blue Clay	328	356
SANDY SHALE	356	365
MED SAND	365	380
BLUE CLAY	380	393
MED. SAND	393	397
BLUE CLAY	397	456
MED. SAND	456	530
BLUE CLAY	530	563
MED. SAND.	563	609

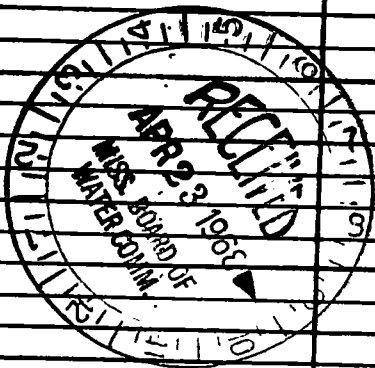

DRILLERS REMARKS:

If well telescopes please sketch and show depths.

GROUND LEVEL

[Faint handwritten notes and sketches of well profiles are visible in this section.]

	XXXX		
	X		

SECTION 19

Please indicate well location X.

ADDITIONAL INFORMATION

[This section contains multiple horizontal lines for handwritten notes, which are mostly illegible.]

If more than one screen, show locations of each on sketch.