

JACKSON
 O 2003
 3-68

MISSISSIPPI
 BOARD OF WATER COMMISSIONERS
 416 North State Street
 Jackson, Mississippi 39201

WATER WELL DRILLERS LOG

3-30-68 date well completed
 19 COAST WATER WELL SERVICE firm name
 JACKSON county well located

LANDOWNER: CAUTIER METHODIST
 CHURCH
 CAUTIER, MISS (mailing address)
 WELL LOCATION:
 sec. 35 T-7 R-7
 C miles west of Bay
 (distance) (direction) (nearest town)

description of formations encountered	from	to
TOO MUCH SOIL	0	14
FINE SAND	14	17
BLUE-GRAY CLAY	17	78
MED. SAND	78	83
BLUE-GRAY SAND CLAY	83	171
FINE SAND	171	178
BLUE-GRAY CLAY	178	200
MED. SAND	200	225


WELL PURPOSE: Church
 (home, irrigation, municipal, industrial)

- WELL COMPLETION DATA:
- (1) diameter (inches) 2"
 - (2) total depth (feet) 225'
 - (3) static water level (feet) 1' below top of ground
 - (4) casing GALV. 220' (material), (depth)
 2" (size) if telescope see back.
 - (5) screen 5' 220' (length), (depth to top)
 2" (size), STAINLESS STEEL (material)
 - (6) pump 1 (HP), 10 (yield gpm)
 Elect (type power)
 - (7) electric log NO (yes or no)

(organization running log)

(8) how well bottom plugged 2" BACK
 WASH VALVE

DRILLERS REMARKS:

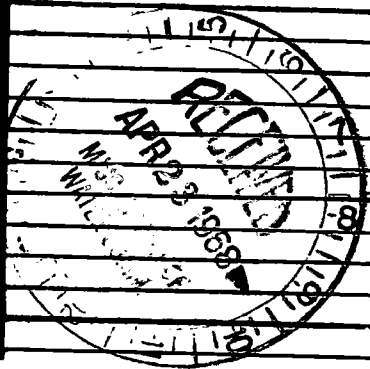

If well telescopes please sketch and show depths.

GROUND LEVEL

Handwritten notes and sketches on the left side of the page, including a vertical line and various scribbles.

	X		

SECTION _____

Please indicate well location X.

ADDITIONAL INFORMATION

Multiple horizontal lines for additional information, with some faint handwritten notes.

If more than one screen, show locations of each on sketch.