

JACKSON  
 0 2004  
 3-68

MISSISSIPPI  
 BOARD OF WATER COMMISSIONERS  
 416 North State Street  
 Jackson, Mississippi 39201

WATER WELL DRILLERS LOG

2-27-68  
 date well completed

19 COAST WATER WELL SERVICE  
 firm name

JACKSON  
 county well located

LANDOWNER: A.C. OLIVE

Fountainblow, Miss.

P.O. Box 35 Fountainblow, Miss.  
 (mailing address)

description of formations  
 encountered

from

to

RED & WHITE CLAY 0 18  
 COARSE SAND & GRAVEL 18 57

WELL LOCATION:

sec. 6 T 7 N R 7 E  
5 miles South of Vandenberg  
 (distance) (direction) (nearest town)


WELL PURPOSE: Home  
 (home, irrigation, municipal, industrial)

WELL COMPLETION DATA:

- (1) diameter (inches) 2"  
 (2) total depth (feet) 57'  
 (3) static water level (feet) 14' below  
 top of ground.  
 (4) casing Galv, 53'  
 (material) (depth)  
2"  
 (size) if telescope see back.  
 (5) screen 4', 53'  
 (length) (depth to top)  
2", PLASTIC  
 (size) (material)  
 (6) pump \_\_\_\_\_  
 (HP) (yield gpm)  
 (type power) \_\_\_\_\_  
 (7) electric log NO  
 (yes or no)  
 (organization running log) \_\_\_\_\_

(8) how well bottom plugged 2" BACK  
WASH VALVE

DRILLERS REMARKS:

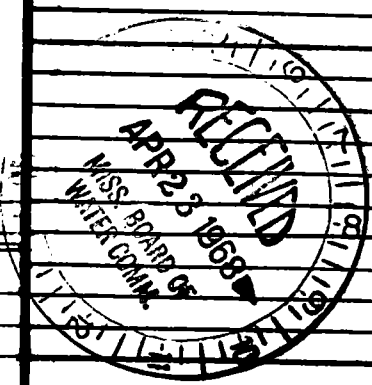

If well telescopes please sketch and show depths.

GROUND LEVEL

			X

SECTION 6

Please indicate well location X.

ADDITIONAL INFORMATION

If more than one screen, show locations of each on sketch.