

**MISSISSIPPI
BOARD OF WATER COMMISSIONERS**
416 North State Street
Jackson, Mississippi 39201

130

WATER WELL DRILLERS LOG

JACKSON
Ø 2005
3-7-75

3/7 1975 **COAST WATER WELL SERVICE INC.** Jackson
date well completed firm name county well located

LANDOWNER: Wayne Semeral
Bayou Oaks Rd.
Gautier, Ms.
(mailing address)


WELL LOCATION:
sec. 26 T-1 R-7
mi Sautier
(distance) miles (direction) of (nearest town)

WELL PURPOSE: Home
(home, irrigation, municipal, industrial)

- WELL COMPLETION DATA:**
- (1) diameter (inches) 2"
 - (2) total depth (feet) 280
 - (3) static water level (feet) 18 below top of ground.
 - (4) casing PVC 270
(material) (depth)
2" If telescope see back.
(size)
 - (5) screen 10 270
(length) (depth to top)
 - 2" PVC
(size) (material)
 - (6) pump 1 8
(HP) (yield gpm)
 - elec.
(type power)
 - (7) electric log NO
(yes or no)
 - (organization running log)
 - (8) how well bottom plugged BIUU

description of formations encountered	from	to
top soil	0	4
Red clay	4	10
Grey clay	10	18
Sand (C)	18	25
Blue clay	25	56
Sand (C)	56	96
Blue clay	96	161
Sand (C)	161	290
		168


DRILLERS REMARKS:

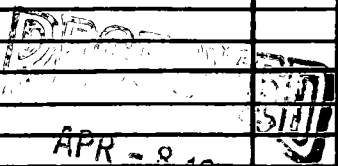

MISS. BD. OF WATER COMM.

If well telescopes please sketch and show depths.

GROUND LEVEL

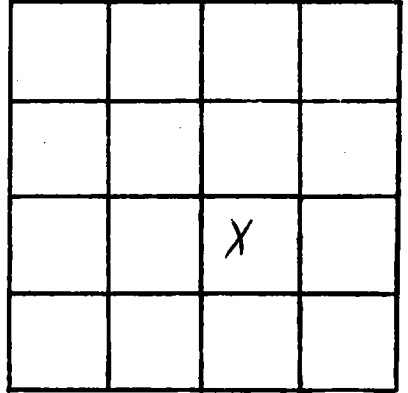

SECTION 26

Please indicate well location X.

ADDITIONAL INFORMATION

If more than one screen,
show locations of each on sketch.