

JACKSON
Ø 2007
6-3-75

MISSISSIPPI
BOARD OF WATER COMMISSIONERS
416 North State Street
Jackson, Mississippi 39201

WATER WELL DRILLERS LOG
COAST WATER WELL SERVICE INC.

6/3 1975 date well completed 1302 firm name Jackson county well located

LANDOWNER: L. & A. Contractor

P.O. Box 639

Nautico, Miss.
(mailing address)

WELL LOCATION:

sec. 11 T. 7 N R. 7 E S. W.
3 1/2 miles (distance) N (direction) of Nautico (nearest town)

WELL PURPOSE: Supply well
(home, irrigation, municipal, industrial)

WELL COMPLETION DATA:

- (1) diameter (inches) 2"
- (2) total depth (feet) 100'
- (3) static water level (feet) 10' below top of ground
- (4) casing PVC (material), 90' (depth)
2" (size) if telescope see back.
- (5) screen 10' (length), 90' (depth to top)
2" (size), PVC (material)
- (6) pump 1 (HP), 7 1/2 (yield gpm)
elec. (type power)
- (7) electric log NO (yes or no)
(organization running log)
- (8) how well bottom plugged B.W.U

description of formations encountered	from to	
top soil	0	2
Blue Clay	2	8
Sand (c)	8	21
Blue Clay	21	53
Sand (m)	53	100


DRILLERS LOG
APR 6 1975
WATER COMMISSIONERS

DRILLERS REMARKS:

WATER COMMISSIONERS

If well telescopes please sketch and show depths.

GROUND LEVEL

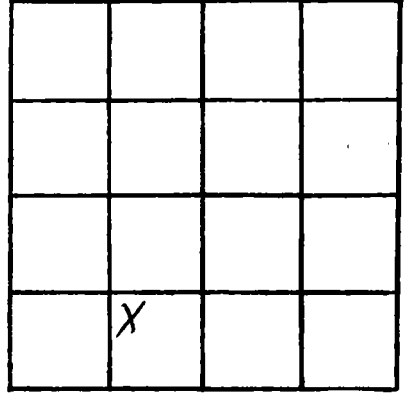

SECTION 11

Please indicate well location X.

ADDITIONAL INFORMATION

Lined area for additional information.

If more than one screen, show locations of each on sketch.