

JACKSON
 2008
 7-2-75

MISSISSIPPI
 BOARD OF WATER COMMISSIONERS
 416 North State Street
 Jackson, Mississippi 39201

WATER WELL DRILLERS LOG

7/2 1975 COAST WATER WELL SERVICE INC. Jackson
 date well completed firm name county well located


LANDOWNER: L.W. Snow
 Shamrock Court
 Gautier, Miss.
 (mailing address)

WELL LOCATION:
 sec. 36 T-7 S, R-7 E
 in Gautier
 (distance) miles (direction) of (nearest town)

WELL PURPOSE: Home
 (home, irrigation, municipal, industrial)

WELL COMPLETION DATA:
 (1) diameter (inches) 2"
 (2) total depth (feet) 289'
 (3) static water level (feet) 19' below top of ground.
 (4) casing PVC, 279' (material) (depth)
 2" (size) if telescope see back.
 (5) screen 10' (length), 279' (depth to top)
 2" (size), PVC (material)
 (6) pump 1 (HP), 8 1/2 (yield gpm)
 elec. (type power)
 (7) electric log NO (yes or no)
 (organization running log)
 (8) how well bottom plugged B.W.U.

description of formations encountered	from	to
top soil	0	4
Red clay	4	10
Blue clay	10	20
White sand (c)	20	36
Blue clay	36	45
sand (c)	45	102
(c) sand + gravel	102	109
Blue clay	109	123
Blue clay + shell	123	187
sand (c)	187	289

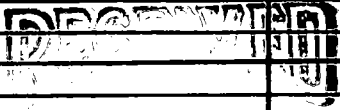


APR - 6 1976

DRILLERS REMARKS:

If well telescopes please sketch and show depths.

GROUND LEVEL

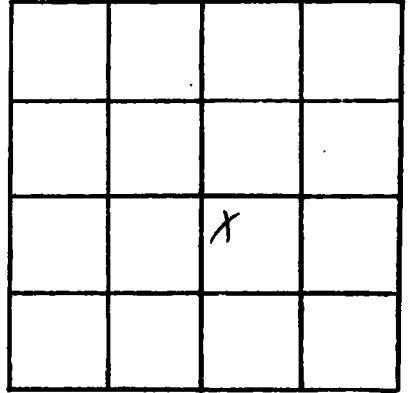

SECTION 36

Please indicate well location X.

ADDITIONAL INFORMATION

If more than one screen, show locations of each on sketch.