

JACKSON
 2010
 8-10-75

MISSISSIPPI
 BOARD OF WATER COMMISSIONERS
 416 North State Street
 132 Jackson, Mississippi 39201

WATER WELL DRILLERS LOG

8/10 date well completed

1975 COAST WATER WELL SERVICE INC. firm name

Jackson county well located

LANDOWNER: Ed Rocko
 119 Shamrock Dr.
 Gautier, Mo. 39553
 (mailing address)

WELL LOCATION:
 sec. 36 T-7 R-7
 in Gautier
 (distance) miles (direction) of (nearest town)

WELL PURPOSE: Home
 (home, irrigation, municipal, industrial)

WELL COMPLETION DATA:
 (1) diameter (inches) 2"
 (2) total depth (feet) 283'
 (3) static water level (feet) 15' below top of ground.
 (4) casing PVC, 273' (material) (depth)
 2" (size) if telescope see back.
 (5) screen 10' 273' (length) (depth to top)
 2" PVC (size) (material)
 (6) pump 1 8 1/2 (HP) (yield gpm)
 elec. (type power)
 (7) electric log NO (yes or no)
 (organization running log)
 (8) how well bottom plugged AWU

description of formations encountered	from	to
top soil	0	4
Red clay	4	10
Blue clay	10	20
sand (c)	20	36
Blue clay	36	45
sand (c)	45	102
sand + gravel	102	109
Blue clay	109	123
Blue clay + shell	123	187
sand (c)	187	283


DRILLERS REMARKS:

APR - 2 1976

MISS. Bd. of WATER COMM

If well telescopes please sketch and show depths.

GROUND LEVEL

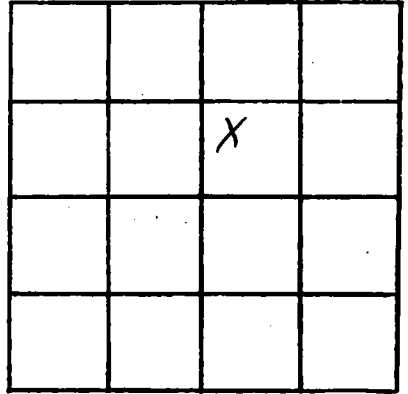

SECTION 36

Please indicate well location X.

ADDITIONAL INFORMATION

If more than one screen, show locations of each on sketch.