

Jackson
 2013
 8-25-75

MISSISSIPPI
 BOARD OF WATER COMMISSIONERS
 416 North State Street
 Jackson, Mississippi 39201

WATER WELL DRILLERS LOG

Aug 25 1975 Corbett Water Jackson
 date well completed firm name county well located


LANDOWNER:	description of formations encountered	from	to
Mrs. C. M. Shepard Jr. Gautier, MS (mailing address)	Sandy clay soft blue clay sand clay sand	0	304 20 176 220 304
WELL LOCATION:			
sec. 14 T. 8 N. R. 7 E. 138 6 miles West of West Point, (distance) (direction) (nearest town)			
WELL PURPOSE: home (home, irrigation, municipal, industrial)			
WELL COMPLETION DATA:			
(1) diameter (inches) 2			
(2) total depth (feet) 304			
(3) static water level (feet) 26 below top of ground			
(4) casing <u>plastic 2 1/2"</u> (material) (depth)			
(size) If telescope see back.			
(5) screen <u>5' 2 1/2"</u> (length) (depth to top)			
<u>2"</u> (size) (material)			
(6) pump <u>1</u> <u>10</u> (HP) (yield gpm)			
<u>elec</u> (type power)			
(7) electric log <u>no</u> (yes or no)			
(organization running log)			
(8) how well bottom plugged <u>BRIDGE</u>			
DRILLERS REMARKS:			

RECORDED
 INDEXED
 OCT 21 1975
 MISSISSIPPI
 STATE ARCHIVES

If well telescopes please sketch and show depths.

GROUND LEVEL

Irregular section

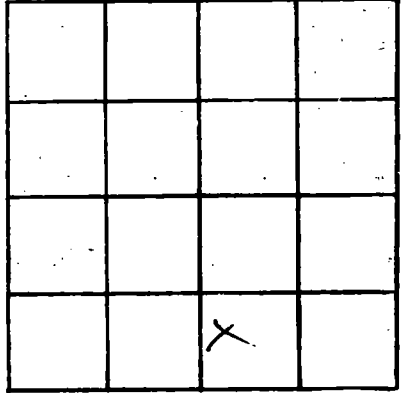

SECTION 14

Please indicate well location X.

ADDITIONAL INFORMATION

If more than one screen, show locations of each on sketch.