

JACKSON
 2015
 11/27/75

**MISSISSIPPI
 BOARD OF WATER COMMISSIONERS**
 416 North State Street
 Jackson, Mississippi 39201

**WATER WELL DRILLERS LOG
 COAST WATER WELL SERVICE INC.**

11/27 1975 date well completed 138 firm name Jackson county well located

LANDOWNER: Fred Schaub
Schaub
Rt. 3
Hautier, Miss.
 (mailing address)


WELL LOCATION:
 sec. 14 T. 8 R. 7
in Hautier
 (distance) (direction) (nearest town)

WELL PURPOSE: None
 (home, irrigation, municipal, industrial)

- WELL COMPLETION DATA:
- (1) diameter (inches) 2"
 - (2) total depth (feet) 588'
 - (3) static water level (feet) 20 ^{below} above top of ground.
 - (4) casing PVC 588'
 (material) (depth)
2" if telescope see back.
 (size)
 - (5) screen 10' 588'
 (length) (depth to top)
2" PVC
 (size) (material)
 - (6) pump 1 8 1/2
 (HP) (yield gpm)
elec.
 (type power)
 - (7) electric log NO
 (yes or no)
 (organization running log)
 - (8) how well bottom plugged BWU

description of formations encountered	from	to
<u>top soil</u>	<u>0</u>	<u>15</u>
<u>Blue Clay</u>	<u>15</u>	<u>62</u>
<u>Sand (C)</u>	<u>62</u>	<u>102</u>
<u>Blue Clay</u>	<u>102</u>	<u>159</u>
<u>Sand (C)</u>	<u>159</u>	<u>179</u>
<u>Blue Clay</u>	<u>179</u>	<u>194</u>
<u>Sand (C)</u>	<u>194</u>	<u>355</u>
<u>Blue Clay</u>	<u>355</u>	<u>375</u>
<u>Sand (C)</u>	<u>375</u>	<u>392</u>
<u>Blue Clay</u>	<u>392</u>	<u>495</u>
<u>Sand (F)</u>	<u>495</u>	<u>513</u>
<u>Sand (M)</u>	<u>513</u>	<u>539</u>
<u>Sand (C)</u>	<u>539</u>	<u>588</u>
		<u>None</u>

DRILLERS REMARKS:

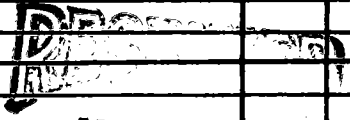

APR - 8 1976

If well telescopes please sketch and show depths.

GROUND LEVEL



		X	

SECTION 14

Please indicate well location X.

ADDITIONAL INFORMATION

If more than one screen, show locations of each on sketch.