

JACKSON

2016

1-9-78

135

MISSISSIPPI BOARD OF WATER COMMISSIONERS
416 North State Street
Jackson, Mississippi 39201

WATER WELL DRILLERS LOG

1/9
date well completed

1978 COAST WATER WELL SERVICE INC.
firm name

Jackson
county well located

LANDOWNER: Paul J. Kieke
2003 Jackson Ave
Lascagula Miss
(mailing address)

description of formations encountered	from	to
top soil	0	1
sand (c)	1	18
blue clay	18	60
sand (c)	60	105


WELL LOCATION:
sec. 14 T 2 R 7 S W
in Gautier
(distance) miles (direction) of (nearest town)

WELL PURPOSE: Home
(home, irrigation, municipal, industrial)

WELL COMPLETION DATA:

- (1) diameter (inches) 2"
- (2) total depth (feet) 105
- (3) static water level (feet) 20 below top of ground.
- (4) casing PVC, 100' (material) (depth)
2" (size) if telescope see back.
- (5) screen 5' 100' (length) (depth to top)
2" (size) PVC (material)
- (6) pump 1/2 (HP) 7 (yield gpm)
Elec. (type power)
- (7) electric log NO (yes or no)
(organization running log)
- (8) how well bottom plugged B.W.


DRILLERS REMARKS:

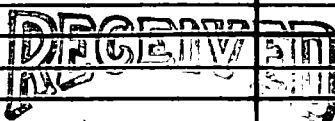

APR - 8 1978

If well telescopes please sketch and show depths.

GROUND LEVEL

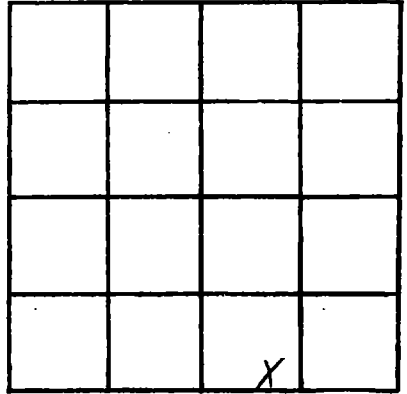

SECTION 14

Please indicate well location X.

ADDITIONAL INFORMATION

If more than one screen, show locations of each on sketch.