

**MISSISSIPPI
BOARD OF WATER COMMISSIONERS
416 North State Street
Jackson, Mississippi 39201**

WATER WELL DRILLERS LOG

COAST WATER WELL SERVICE INC.

JACKSON
 2019
 2/25/76

2/25 1976
 date well completed

firm name

Jackson
 county well located

LANDOWNER: <u>Juris Cities</u>	description of formations encountered	from	to
<u>Saving + Loan Assn.</u>	<u>top soil</u>	<u>0</u>	<u>1</u>
<u>Hautier, Ms.</u> (mailing address)	<u>Sand - fine</u>	<u>1</u>	<u>7</u>
WELL LOCATION:	<u>blue clay</u>	<u>7</u>	<u>25</u>
sec. <u>35</u> T. <u>7</u> N R. <u>7</u> E	<u>Sand - coarse</u>	<u>25</u>	<u>50</u>
miles <u>in Hautier</u> (distance) (direction) of (nearest town)	<u>Sand - Med</u>		
WELL PURPOSE: <u>Bank</u> (home, irrigation, municipal, industrial)	<u>Blue clay</u>	<u>50</u>	<u>80</u>
WELL COMPLETION DATA:	<u>Sand - med.</u>	<u>80</u>	<u>95</u>
(1) diameter (inches) <u>2"</u>			<u>100</u>
(2) total depth (feet) <u>95'</u>			
(3) static water level (feet) <u>25</u> below above top of ground.			
(4) casing <u>PVC</u> , <u>85'</u> , <u>1</u> (material) (depth) <u>2"</u> if telescope see back. (size)			
(5) screen <u>10'</u> , <u>85'</u> (length) (depth to top)			
(6) pump <u>2"</u> , <u>PVC</u> (size) (material)			
(6) pump <u>1/2</u> <u>7</u> (HP) (yield gpm)			
<u>elec.</u> (type power)			
(7) electric log <u>NO</u> (yes or no)			
<u>(organization running log)</u>			
(8) how well bottom plugged <u>B w valve</u>			


RECEIVED
 JUN 28 1976

DRILLERS REMARKS:

MISS. BD. OF WATER COMMISSIONERS

If well telescopes please sketch and show depths.

GROUND LEVEL

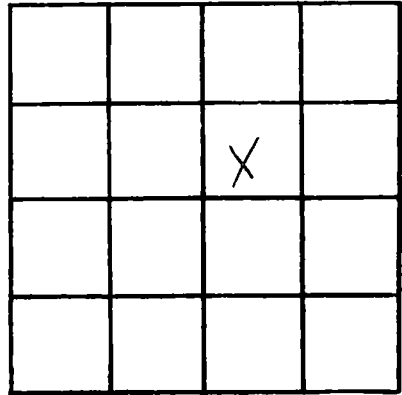

SECTION 35

Please indicate well location X.

ADDITIONAL INFORMATION

If more than one screen, show locations of each on sketch.