

*PA Jackson*  
*etc.*

JACKSON  
Ø 2021  
2-28-76

MISSISSIPPI  
BOARD OF WATER COMMISSIONERS  
416 North State Street  
136 Jackson, Mississippi 39201

WATER WELL DRILLERS LOG  
COASTAL DRILLING & SERVICE CO.

2/28 1976  
date well completed

ROUTE 1 BOX 618

*Jackson*  
county well located

LANDOWNER: *Jerry [unclear]*  
*pt 6 Bul 840*  
*Ocean Springs, Miss*  
(mailing address)

description of formations encountered	from	to
39532 Top soil	1	3
Red Clay	3	15
white sand	15	120
Soft Blue Clay	120	240
fine water sand	240	265
hard blue clay	265	440
fine water sand	440	455
hard blue clay	455	570
fine water sand	570	580
Coarse water sand	580	605

WELL LOCATION:  
sec 29 T 7N R 7E  
*Fountain Bluffs*  
miles (distance) of (direction) (nearest town)

WELL PURPOSE: *home*  
(home, irrigation, municipal, industrial)

WELL COMPLETION DATA:

(1) diameter (inches) 2"

(2) total depth (feet) 605'

(3) static water level (feet) 35' <sup>below</sup> <sub>above</sub> top of ground.

(4) casing PVC 595'  
(material) (depth)

\_\_\_\_\_ If telescope see back.  
(size)

(5) screen 10' 595'  
(length) (depth to top)

2" PVC  
(size) (material)

(6) pump one 15  
(HP) (yield gpm)


elec  
(type power)

(7) electric log no  
(yes or no)

\_\_\_\_\_ (organization running log)

(8) how well bottom plugged  
2" backwash valve

DRILLERS REMARKS:  
none

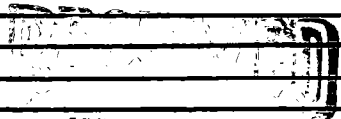

MAR 25 1976

If well telescopes please sketch and show depths.

GROUND LEVEL

X			

SECTION \_\_\_\_\_

Please indicate well location X.

ADDITIONAL INFORMATION

If more than one screen, show locations of each on sketch.