

JACKSON

MISSISSIPPI BOARD OF WATER COMMISSIONERS 416 North State Street Jackson, Mississippi 39201

132

2024 3-16-76

WATER WELL DRILLERS LOG

3/16 date well completed

1976 COAST WATER WELL SERVICE INC. firm name

Jackson county well located

LANDOWNER: Ed Barlow

description of formations encountered

from to

3716 90 Beth Dr.

Top Soil

0 5

Hunter, Mo. (mailing address)

Red Clay

5 10

WELL LOCATION:

Gray Clay

10 22

sec 36 T 7 R 7 in Hunter Mo. (distance) miles (direction) of (nearest town)

Gray Coarse Sand & Gravel

22 168

WELL PURPOSE: home (home, irrigation, municipal, industrial)

Blue Clay

168 179

WELL COMPLETION DATA:

Gray Coarse Sand

179 270

- (1) diameter (inches) 2"
(2) total depth (feet) 270'
(3) static water level (feet) 21' below top of ground.
(4) casing 2" (material), 260' (depth)
(5) screen 10' (length), 260' (depth to top)
(6) pump NONE (HP), PVC (material), (yield gpm)

(7) electric log (yes or no)

(8) how well bottom plugged b/w value

DRILLERS REMARKS:

RECEIVED

JUN 28 1976

Miss. Bd. OF WATER COMMISSIONERS

If well telescopes please sketch and show depths.


GROUND LEVEL

		X	

SECTION 36

Please indicate well location X.

ADDITIONAL INFORMATION

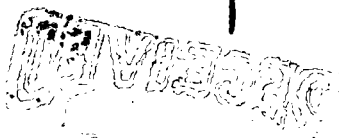

If more than one screen, show locations of each on sketch.