

JACKSON
 # 2078
 6-4-76

MISSISSIPPI
 BOARD OF WATER COMMISSIONERS
 416 North State Street
 Jackson, Mississippi 39201

WATER WELL DRILLERS LOG
 COASTAL DRILLING & SERVICE CO.

6/4 1976 date well completed
 ROUTE 1 BOX 618 JACKSON BILOXI, MISS. 39552
 county well located

LANDOWNER: Jim Temple
 Rt 4 Box 638 D
 Ocean Springs, Miss
 (mailing address)

description of formations encountered	from	to
top soil	1	3
Red Clay	3	15
Coarse white sand	15	40
Swamp sand	40	65
Soft Blue Clay	65	100
Coarse white sand	100	160
Soft Blue Clay	160	320
Coarse white sand	320	325
hard blue clay	325	400
fine white sand	400	420
Coarse white sand	420	465

WELL LOCATION:
 sec. 6 T 8 N R 7 E
 (S) (W)
 4.0 miles SW of Ocean Springs
 (distance) (direction) (nearest town)

WELL PURPOSE: home
 (home, irrigation, municipal, industrial)

- WELL COMPLETION DATA:
- (1) diameter (inches) 2"
 - (2) total depth (feet) 465'
 - (3) static water level (feet) 22' below top of ground
 - (4) casing PVC, 45' (material) (depth)
 (size) if telescope see back.
 - (5) screen 10' (length), 455' (depth to top)
 2" (size), PVC (material)
 - (6) pump 0.75 (HP), 14 (yield gpm)
 Ele (type power)
 - (7) electric log no (yes or no)
- (organization running log)


(8) how well bottom plugged
 2" bent water tubes

DRILLERS REMARKS:
 none

RECEIVED
 JUN 29 1976

If well telescopes please sketch and show depths.

GROUND LEVEL

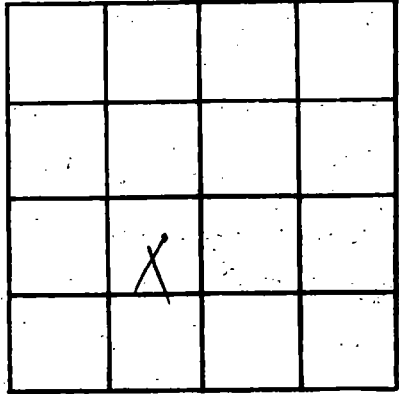

SECTION _____

Please indicate well location X.

ADDITIONAL INFORMATION

If more than one screen, show locations of each on sketch.