

JACKSON
 2830
 6/25/76

MISSISSIPPI
 BOARD OF WATER COMMISSIONERS
 416 North State Street
 Jackson, Mississippi 39201

WATER WELL DRILLERS LOG
 WASTE DRILLING & SERVICE CO.

6/25/76 ROUTE 1 BOX 618
 date well completed firm name
 BILOXI, MISS 39532
 county well located *Jackson*

YAN DOWNER:
Yan Downer
 425 Porter Ave
 Ocean Springs, Miss
 (mailing address)

description of formations encountered	from	to
Top Soil	1	3
Red Clay	3	18
white sand	18	60
Super Sand	60	75
Soft Blue Clay	75	150
White Sand	150	210
Soft Blue Clay	210	315
Spells	315	320
Water sand fire	320	345
hard blue clay	345	395
fine water sand	395	410
Coarse water sand	410	445


WELL LOCATION:
 sec. 29 T. 2 S. R. 2 E.
7000 miles
 (distance) (direction) (nearest town)

WELL PURPOSE: *Home*
 (home, irrigation, municipal, industrial)

- WELL COMPLETION DATA:
- (1) diameter (inches) 2"
 - (2) total depth (feet) 445
 - (3) static water level (feet) 20 ^{below} _{above} top of ground.
 - (4) casing PVC 435'
 (material) (depth)
 (size) If telescope see back.
 - (5) screen 10' 435'
 (length) (depth to top)
2" PVC
 (size) (material)
 - (6) pump One 15
 (HP) (yield gpm)
Elc
 (type power)
 - (7) electric log no
 (yes or no)
- (organization running log)

(8) how well bottom plugged
2nd best with dble

DRILLERS REMARKS:
None

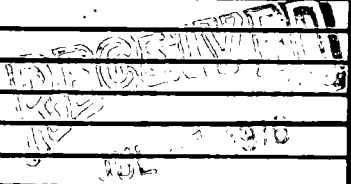

MISS. BD. OF WATER COMMISSIONERS

