

JACKSON
 P 7038
 11/18/76

MISSISSIPPI
 BOARD OF WATER COMMISSIONERS
 416 North State Street
 135 Jackson, Mississippi 39201

WATER WELL DRILLERS LOG

11/18 1976 Coast Water Well Inc. Jackson
 date well completed firm name county well located

LANDOWNER: <u>Lennie Jones</u>	description of formations encountered	from	to
<u>Rt. 6, Box 118C</u>			
<u>Ocean Springs, Ms.</u> (mailing address)	<u>coarse white sand</u>	<u>10</u>	<u>152</u>
WELL LOCATION: sec. <u>29 T 7 N</u> R. <u>7 E</u> in <u>Fauntleroy</u> <u>blau</u> (distance) miles (direction) of (nearest town)	<u>blue clay + streaks sand</u>	<u>152</u>	<u>515</u>
	<u>fine grey sand</u>	<u>515</u>	<u>560</u>
	<u>coarse grey sand</u>	<u>560</u>	<u>590</u>

WELL PURPOSE: Home
 (home, irrigation, municipal, industrial)

- WELL COMPLETION DATA:
- (1) diameter (inches) 2"
 - (2) total depth (feet) 590'
 - (3) static water level (feet) 36 ^{below} _{above} top of ground.
 - (4) casing 2" (material) 570' (depth)
2" (size) if telescope see back.
 - (5) screen 20' (length) 590' (depth to top)
2" (size) PVC (material)
 - (6) pump _____ (HP) _____ (yield gpm)
 _____ (type power)
 - (7) electric log NO (yes or no)
 _____ (organization running log)
 - (8) how well bottom plugged Blw Valve


DRILLERS REMARKS:

RECEIVED
 MAR - 9 1977

MISS. BD. OF WATER COMMISSIONERS

If well telescopes please sketch and show depths.

GROUND LEVEL

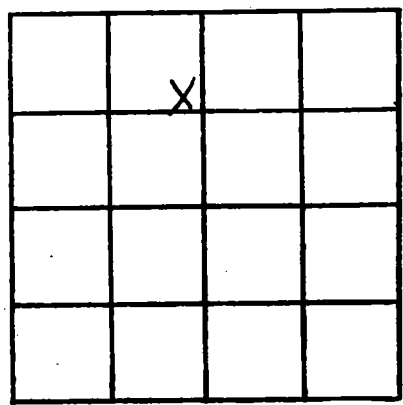

SECTION 29

Please indicate well location X.

ADDITIONAL INFORMATION

A series of horizontal lines for writing additional information, starting below the 'ADDITIONAL INFORMATION' header and extending to the bottom of the page.

If more than one screen, show locations of each on sketch.