

JACKSON
 2040
 11/2/76

MISSISSIPPI
 BOARD OF WATER COMMISSIONERS
 416 North State Street
 Jackson, Mississippi 39201

WATER WELL DRILLERS LOG

11/2 1976 Coast Water Well Serv. Jackson
 date well completed firm name county well located

LANDOWNER: Curtis Loyal
Gautier, Mo.
 (mailing address)
 WELL LOCATION:
 sec. 3 T. 8 R. 7
in Gautier
 (distance) miles (direction) of (nearest town)

WELL PURPOSE: Home
 (home, irrigation, municipal, industrial)

WELL COMPLETION DATA:
 (1) diameter (inches) 2"
 (2) total depth (feet) 319'
 (3) static water level (feet) 25 ^{below} _{above} top of ground.
 (4) casing PVC 309'
 (material) (depth)
2" if telescope see back.
 (size)
 (5) screen 10' 309'
 (length) (depth to top)
2" PVC
 (size) (material)
 (6) pump 1 9
 (HP) (yield gpm)
elec.
 (type power)
 (7) electric log NO
 (yes or no)
 (organization running log)
 (8) how well bottom plugged blw valve

description of formations encountered	from	to
<u>top soil</u>	<u>0</u>	<u>1</u>
<u>white clay</u>	<u>1</u>	<u>15</u>
<u>grey clay</u>	<u>15</u>	<u>74</u>
<u>coarse grey sand</u>	<u>74</u>	<u>133</u>
<u>blue clay</u>	<u>133</u>	<u>149</u>
<u>coarse grey sand</u>	<u>149</u>	<u>177</u>
<u>blue clay</u>	<u>177</u>	<u>206</u>
<u>fine grey sand</u>	<u>206</u>	<u>260</u>
<u>coarse grey sand</u>	<u>260</u>	<u>319</u>
		<u>hole</u>


RECEIVED
 MAR - 9 1977

ATER CO.

DRILLERS REMARKS:

If well telescopes please sketch and show depths.

GROUND LEVEL

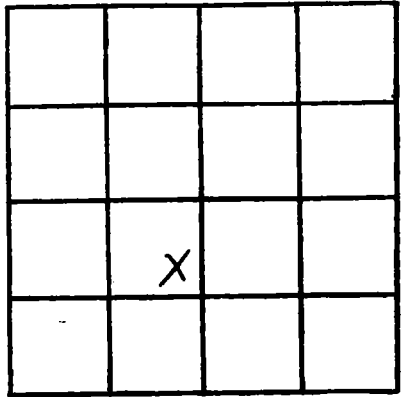

SECTION 3

Please indicate well location X.

ADDITIONAL INFORMATION

If more than one screen, show locations of each on sketch.