

JACKSON  
 P 2041  
 12/29/76

MISSISSIPPI  
 BOARD OF WATER COMMISSIONERS  
 416 North State Street  
 135 Jackson, Mississippi 39201

WATER WELL DRILLERS LOG

12/29 1976 date well completed  
 COAST WATER WELL SERVICE INC. firm name  
 Jackson county well located

LANDOWNER: Gautier Co Wash  
Vanhook - Short Cut Road  
Gautier, Miss 39553  
 (mailing address)

| description of formations encountered | from | to  |
|---------------------------------------|------|-----|
| Top Soil                              | 0    | 10  |
| Blue Clay                             | 10   | 40  |
| Red Med. Sand                         | 40   | 45  |
| Gray Clay                             | 45   | 66  |
| White Coarse Sand                     | 66   | 105 |

WELL LOCATION:  
 sec. 35 T 7 N R. 7 W  
 in Gautier  
 (distance) miles (direction) of (nearest town)

WELL PURPOSE: car wash  
 (home, irrigation, municipal, industrial)

- WELL COMPLETION DATA:
- (1) diameter (inches) 4
  - (2) total depth (feet) 105
  - (3) static water level (feet) 30 <sup>(below)</sup> <sub>(above)</sub> top of ground.
  - (4) casing 4 (material), 95' (depth)  
4 (size) if telescope see back.
  - (5) screen 10 (length), 95' (depth to top)  
4 (size), PVC (material)
  - (6) pump 1 hp. (HP), 8 1/2 (yield gpm)  
Electric (type power)
  - (7) electric log No (yes or no)

(organization running log)

(8) how well bottom plugged Sp. Valve

**RECEIVED**


MAR - 9 1977

DRILLERS REMARKS:

MISSISSIPPI BOARD OF WATER COMMISSIONERS

If well telescopes please sketch and show depths.

GROUND LEVEL

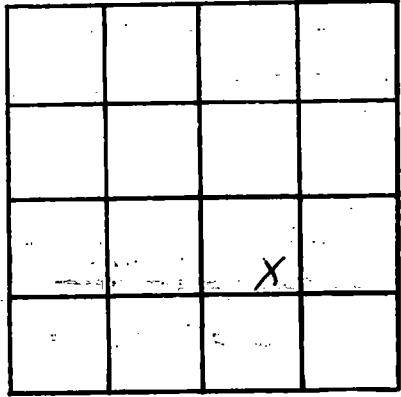

SECTION 35

Please indicate well location X.

ADDITIONAL INFORMATION

If more than one screen, show locations of each on sketch.