

Jackson
 P 7043
 1/26/77

MISSISSIPPI
 BOARD OF WATER COMMISSIONERS
 416 North State Street
 Jackson, Mississippi 39201

WATER WELL DRILLERS LOG

1-26-77 1977 COAST WATER WELL SERVICE Jackson
 date well completed firm name county well located

LANDOWNER: J. Cannon
 Rt 6 - Box 348
 Ocean Springs, Miss.
 (mailing address) 39564

| description of formations encountered | from | to |
|---------------------------------------|------|----|
| Top Soil + sand | 0 | 3 |
| Grey Clay | 3 | 12 |
| Sand (course) | 12 | 21 |
| Grey Clay | 21 | 55 |
| Sand (m.c) | 55 | 90 |

WELL LOCATION:
 sec. 16 T. 7 R. 7
 5 miles N.E. of Ocean Springs
 (distance) (direction) (nearest town)

WELL PURPOSE: Home
 (home, irrigation, municipal, industrial)

WELL COMPLETION DATA:

(1) diameter (inches) 3 1/2

(2) total depth (feet) 90

(3) static water level (feet) 10 below top of ground

(4) casing PVC 80 (material) (depth)

2 (size) If telescope see back.

(5) screen 10 80 (length) (depth to top)

2 PVC (size) (material)

(6) pump (HP) (yield gpm)

(type power)

(7) electric log No (yes or no)

(organization running log)

(8) how well bottom plugged Back Wash Valve


DRILLERS REMARKS:

RECEIVED
 MAR - 9 1977

MISS. BD. OF WATER COMM.

If well telescopes please sketch and show depths.

GROUND LEVEL

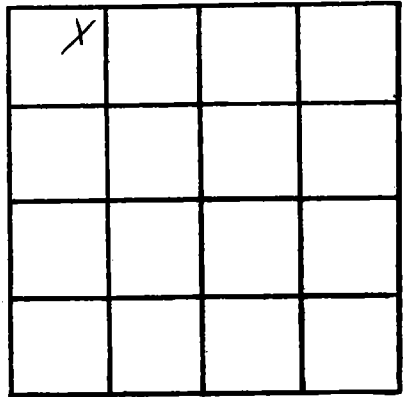

SECTION 16

Please indicate well location X.

ADDITIONAL INFORMATION

If more than one screen, show locations of each on sketch.