

JACKSON
 2045
 2/3/77

MISSISSIPPI
 BOARD OF WATER COMMISSIONERS
 416 North State Street
 Jackson, Mississippi 39201

WATER WELL DRILLERS LOG

2/3 1977 COAST WATER WELL SERVICE Jackson
 date well completed firm name county well located

LANDOWNER: Leon Welch
 4521 N. Market St.
 Pascagoula, Miss. 39567
 (mailing address)

WELL LOCATION:
 sec. 32 T 7 N R 7 W
 4 1/2 miles W. of Gautier
 (distance) (direction) (nearest town)

WELL PURPOSE: Home
 (home, irrigation, municipal, industrial)

WELL COMPLETION DATA:
 (1) diameter (inches) - 2 -
 (2) total depth (feet) 520
 (3) static water level (feet) 35 (below above top of ground)
 (4) casing PVC 510' (material) (depth)
 2" (size) If telescope see back.
 (5) screen 10' 510' (length) (depth to top)
 2" PVC (size) (material)
 (6) pump 1 hp. 8 (HP) (yield gpm)
 Elect. (type power)
 (7) electric log No (yes or no)
 (organization running log)

description of formations encountered	from	to
Top Soil	0	1
Red Clay	1	6
Sand (med)	6	11
Blue Clay	11	46
Sand Gravel	46	65
Blue Clay	65	97
Sand (C)	97	159
Blue Clay	159	475
Sand (med)	475	520

(8) how well bottom plugged Jack used Valve


DRILLERS REMARKS:

RECEIVED
 MAR - 9 1977

MISS. BD. OF WATER COMMISSIONERS

If well telescopes please sketch and show depths.

GROUND LEVEL

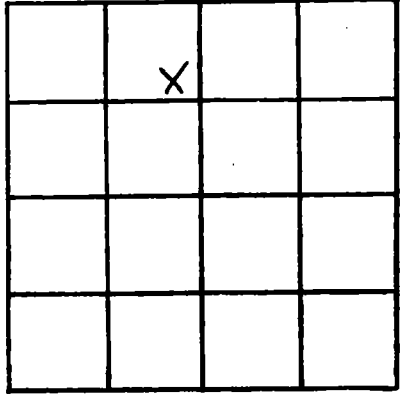

SECTION 32

Please indicate well location X.

ADDITIONAL INFORMATION

If more than one screen,
show locations of each on sketch.