

JACKSON
 φ 20' 46
 2-4-77

MISSISSIPPI
 BOARD OF WATER COMMISSIONERS
 416 North State Street
 Jackson, Mississippi 39201

WATER WELL DRILLERS LOG

COAST WATER WELL SERVICE

2-4
 date well completed

1977

firm name

Jackson
 county well located

LANDOWNER:
 Jackson County Park
 3103 Magnolia
 Pascagoula, Miss. 39564
 (mailing address)

description of formations encountered	from	to
Red Clay	0	43
Sand (med. Coarse)	43	105
Blue Clay	105	145
Sand (med. Coarse)	145	220

WELL LOCATION:

sec. 10 T 7 N R 7 W
 5 1/2 miles N of Gautier
 (distance) (direction) (nearest town)

WELL PURPOSE: Supply
 (home, irrigation, municipal, industrial)

WELL COMPLETION DATA:

- (1) diameter (inches) 2
- (2) total depth (feet) 220
- (3) static water level (feet) 30' below top of ground
- (4) casing PVC, 210' depth
 2 (size) If telescope see back.
- (5) screen 10 (length), 210 (depth to top)
 2 (size), PVC (material)
- (6) pump 1 hp. (HP), 8 1/2 (yield gpm)
 Electric (type power)
- (7) electric log No (yes or no)
 (organization running log)

(8) how well bottom plugged Backwash Valve


DRILLERS REMARKS:

RECEIVED
 MAR - 9 1977

MISS. BD. OF WATER COMM.

If well telescopes please sketch and show depths.

GROUND LEVEL

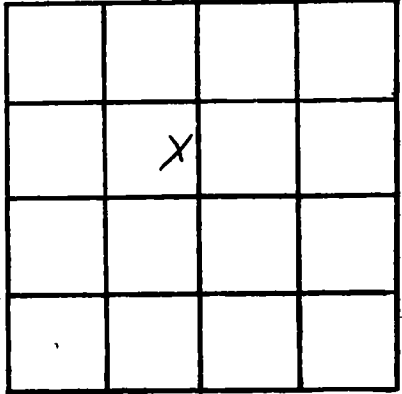

SECTION 10

Please indicate well location X.

ADDITIONAL INFORMATION

If more than one screen,
show locations of each on sketch.