

JACKSON
 # 2048
 2/24/77

MISSISSIPPI
 BOARD OF WATER COMMISSIONERS
 416 North State Street
 Jackson, Mississippi 39201

WATER WELL DRILLERS LOG

2-24
 date well completed

1977 COAST WATER WELL SERVICE
 firm name

Jac Bar
 county well located

LANDOWNER:
 Jac Bar County Bar
 3103 Magnolia
 Pascagoula Miss 39567
 (mailing address)

description of formations encountered	from	to
Top soil	0	30
Med. sand	30	40
blue clay	40	75
fine to coarse sand & gravel	75	180
blue clay	180	300
sand fine to med.	300	370

WELL LOCATION:

sec. 20 T 7 N R 7 W
 in 7th meridian
 (distance) miles (direction) of (nearest town)

WELL PURPOSE: Supply
 (home, irrigation, municipal, industrial)

WELL COMPLETION DATA:

- (1) diameter (inches) 2"
- (2) total depth (feet) 370'
- (3) static water level (feet) 60' below top of ground.
- (4) casing P.V.C. 360' (material) (depth)
 2" (size) if telescope see back.
- (5) screen 10' 360' (length) (depth to top)
 2" (size) P.V.C. (material)
- (6) pump 1 hp. 6 1/2 (HP) (yield gpm)
 electric (type power)
- (7) electric log No (yes or no)
- (organization running log)

(8) how well bottom plugged Jackwest Valve


RECEIVED
 MAR - 9 1977

DRILLERS REMARKS:

MISSISSIPPI BOARD OF WATER COMMISSIONERS

If well telescopes please sketch and show depths.

GROUND LEVEL

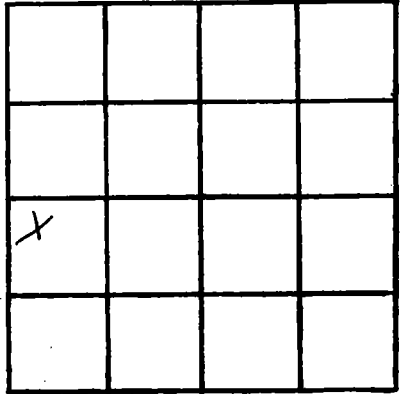

SECTION 20

Please indicate well location X.

ADDITIONAL INFORMATION

If more than one screen, show locations of each on sketch.