

JACKSON
 2849
 3/16/77

MISSISSIPPI
 BOARD OF WATER COMMISSIONERS
 416 North State Street
 Jackson, Mississippi 39201

WATER WELL DRILLERS LOG


3-16 1977 coast water well serv. Jackson
 date well completed firm name county well located

LANDOWNER: Paul Albrecht	description of formations encountered	from	to
3413 Shenrock Ct.			
Dauter, Mo. 39553 (mailing address)	red clay	2	12
WELL LOCATION: sec. 36 T 7 R 7 in Dauter (distance) miles (direction) of (nearest town)	gray clay	12	38
	coarse sand	38	75 Hole
WELL PURPOSE: <u>dom.</u> (home, irrigation, municipal, industrial)			
WELL COMPLETION DATA: (1) diameter (inches) <u>2"</u>			
(2) total depth (feet) <u>75'</u>			
(3) static water level (feet) <u>21</u> below above top of ground.			
(4) casing <u>PVC</u> , <u>70'</u> CL (material) (depth) <u>2"</u> If telescope see back. (size)			
(5) screen <u>5'</u> , <u>70'</u> (length) (depth to top) <u>2"</u> , <u>PVC</u> (size) (material)			
(6) pump _____ (HP) (yield gpm) _____ (type power)			
(7) electric log <u>NO</u> (yes or no) _____ (organization running log)			
(8) how well bottom plugged <u>B/w Valve</u>			
DRILLERS REMARKS:			

RECEIVED
 MAR 18 1977
 MISS. BD. OF WATER COMMISSIONERS

If well telescopes please sketch and show depths.

GROUND LEVEL

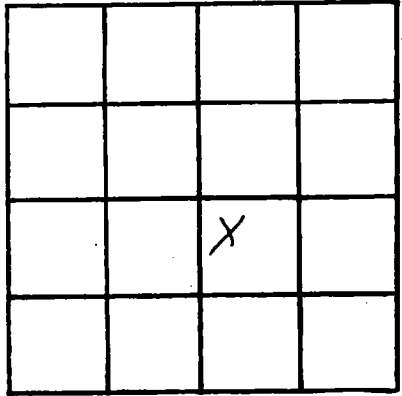

SECTION 36

Please indicate well location X.

ADDITIONAL INFORMATION

If more than one screen, show locations of each on sketch.