

JACKSON  
 2050  
 3/15/77

MISSISSIPPI  
 BOARD OF WATER COMMISSIONERS  
 416 North State Street  
 Jackson, Mississippi 39201

WATER WELL DRILLERS LOG


3-15 1977 Coast Water Well Serv. Jackson  
 date well completed firm name county well located

LANDOWNER: <u>Melvin Taylor</u>	description of formations encountered	from	to
	<u>top soil</u>	<u>0</u>	<u>11</u>
<u>Hautier, Mo. 39553</u> (mailing address)	<u>gray clay</u>	<u>11</u>	<u>58</u>
WELL LOCATION: sec. <u>12</u> T <u>8</u> R <u>7</u> W <u>in Hautier</u> (distance) miles (direction) of (nearest town)	<u>coarse sand</u>	<u>58</u>	<u>85</u> <u>11de</u>
WELL PURPOSE: <u>home</u> (home, irrigation, municipal, industrial)			
WELL COMPLETION DATA: (1) diameter (inches) <u>2"</u> (2) total depth (feet) <u>85'</u> (3) static water level (feet) <u>25'</u> <sup>below</sup> <sub>above</sub> top of ground. (4) casing <u>PVC</u> , <u>80'</u> , <u>ck</u> (material) (depth) <u>2"</u> if telescope see back. (size) (5) screen <u>5'</u> , <u>80'</u> (length) (depth to top) <u>2"</u> , <u>PVC</u> (size) (material) (6) pump <u>1/2</u> , <u>7 1/2</u> (HP) (yield gpm) <u>elec.</u> (type power) (7) electric log <u>NO</u> (yes or no) (organization running log) (8) how well bottom plugged <u>Blue Water</u>			
DRILLERS REMARKS:			

**RECEIVED**  
 MAR 18 1977  
 MISS. BD. OF WATER COMM.

If well telescopes please sketch and show depths.

GROUND LEVEL

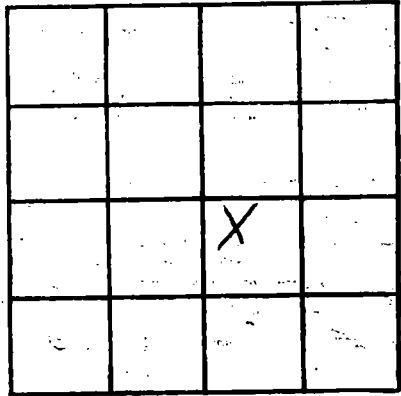

SECTION <sup>12</sup> ~~12~~

Please indicate well location X.

ADDITIONAL INFORMATION

If more than one screen, show locations of each on sketch.