

Jackson
 2055
 7/30/77

MISSISSIPPI
 BOARD OF WATER COMMISSIONERS
 416 North State Street
 Jackson, Mississippi 39201

135

WATER WELL DRILLERS LOG

7/30/77 19 date well completed
 Coastal Drilling firm name
 Jackson county well located

LANDOWNER: Roger Fletcher
 Pt 2 Bof 324
 Ocean Springs, Miss
 (mailing address)

description of formations encountered	from	to
Top Soil	1	5
Red Clay	5	20
Sugar Sand	20	45
Coarse White Sand	45	60
Shells	60	65
fine white sand	65	100
soft blue clay	100	320
hard blue clay	320	460
fine white sand	460	475
Coarse white sand	475	520
		140e

WELL LOCATION:
 sec. 29 T. 7 N. R. 7 E.
 Fantanbleau
 (distance) (direction) (nearest town)

WELL PURPOSE: home
 (home, irrigation, municipal, industrial)

- WELL COMPLETION DATA:
- (1) diameter (inches) 5"
 - (2) total depth (feet) 520
 - (3) static water level (feet) 60 ^{below} _{above} top of ground.
 - (4) casing PVC, 500' ^{OL}
 (material) (depth)
 - (size) if telescope see back.
 - (5) screen 10' 510'
 (length) (depth to top)
 2" PVC
 (size) (material)
 - (6) pump One 12
 (HP) (yield gpm)
 Ele
 (type power)
 - (7) electric log no
 (yes or no)

(organization running log)

(8) how well bottom plugged
 2nd bottom hole plugged


DRILLERS REMARKS:

RECEIVED
 DEC 15 1977

MISS. BD. OF WATER COMM

If well telescopes please sketch and show depths.

GROUND LEVEL

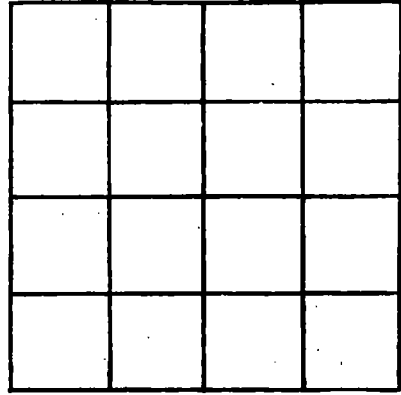

SECTION _____

Please indicate well location X.

ADDITIONAL INFORMATION

If more than one screen, show locations of each on sketch.