

**MISSISSIPPI
BOARD OF WATER COMMISSIONERS
416 North State Street
Jackson, Mississippi 39201**

WATER WELL DRILLERS LOG

092058
9/2/77

9-2-77 1977 Coast Water Well Sew. Jackson
date well completed firm name county well located

LANDOWNER: J.C. Goff
P.O. Box 274 V
Ocean Springs, Miss. 39564
(mailing address)

WELL LOCATION:
sec. 19 T. 8 R. 7
1 1/2 miles S.West of Gautier
(distance) (direction) (nearest town)

WELL PURPOSE: Home
(home, irrigation, municipal, industrial)

WELL COMPLETION DATA:

(1) diameter (inches) 2"
(2) total depth (feet) 515'
(3) static water level (feet) 26' below top of ground.
(4) casing P.V.C. 510'
(material) (depth)
2" If telescope see back.
(size)
(5) screen 10' 500'
(length) (depth to top)
2" P.V.C.
(size) (material)
(6) pump 1 h.p. 9
(HP) (yield gpm)
Elect
(type power)
(7) electric log No
(yes or no)
(organization running log)

(8) how well bottom plugged
Back Wash Valve

description of formations encountered	from	to
Top soil	0	5
Coarse Sand & Gravel	5	110
Blue Clay	110	180
Med. sand	180	215
Fine sand	215	320
Blue Clay	320	340
Fine sand	340	372
Blue Clay	372	387
Fine sand	387	395
Blue Clay	395	415
Med. sand	415	468
Clay	468	475
Coarse sand	475	480
	480	515

RECEIVED


JAN 16 1978

MISS. BD. OF WATER COMMISSIONERS

DRILLERS REMARKS:

If well telescopes please sketch and show depths.

GROUND LEVEL

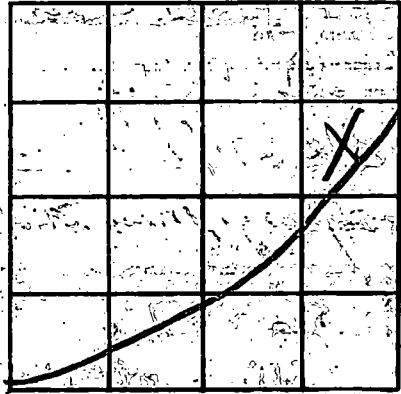

SECTION 19

Please indicate well location X.

ADDITIONAL INFORMATION

If more than one screen, show locations of each on sketch.